


21806150000

U. S. PUBLIC LAND SURVEY MONUMENT RECORD

SECTION 22 T 18 N, R 6 W, TOWN OF FARMINGTON
 LA CROSSE COUNTY

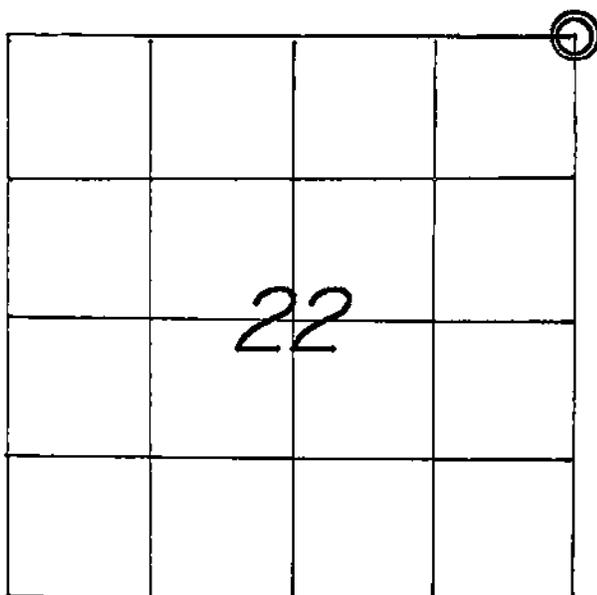

WISCONSIN COORDINATE SYSTEM

North 741,067.672

East 1,686,535.064

Theta Angle

Horiz. Order

Vert. Order

DATUM: 1983 ('91)

TYPE OF LANDMARK

3/4" x 30" IRON BAR WITH RED PLASTIC CAP.

BEARINGS ARE REFERENCED TO

GRID NORTH AS PER SECTION DATA.

LOCATION OF LANDMARK

CREW: WILLIAM C. JUNG

PETER F. FOLLANSBEE

DATE: 12/13/2002

Describe any record evidence, monument evidence, testimonial evidence or any other material evidence you considered and whether the monument was found or restored through acceptance of an obliterated evidence location.

I set this corner on line with the old line fence South of "T" and equidistant between the 1/4 corners to the North and South. Proportionally, this fits the original notes very well, not only North-South, but also East-West. To the East is a "ten acre" fence which also fits very good. I set an iron bar at the corner, buried in the field.

Describe or show any material discrepancy between the location of the restored corner and that of the corner previously restored or reestablished.

NONE KNOWN.

