


U. S. PUBLIC LAND SURVEY MONUMENT RECORD

SECTION 22 T 18 N, R 6 W, TOWN OF FARMINGTON

LA CROSSE COUNTY

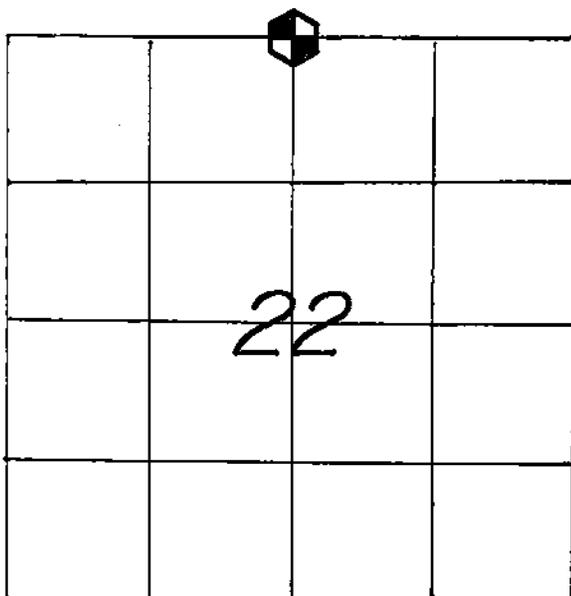

WISCONSIN COORDINATE SYSTEM	
North	741,123.391
East	1,683,935.926
Theta Angle	
Horiz. Order	
Vert. Order	
DATUM:	1983('91)
TYPE OF LANDMARK	
BRASS CAP LUNDE MARKER.	
BEARINGS ARE REFERENCED TO	
GRID NORTH AS PER SECTION DATA.	

LOCATION OF LANDMARK

CREW: WILLIAM G. JUNG
 PETER F. FOLLANSBEE
 DATE: 12/16/2002

Describe any record evidence, monument evidence, testimonial evidence or any other material evidence you considered and whether the monument was found or restored through acceptance of an obliterated evidence location.


I set this corner "as per law" by single proportionate measurement and monumented the corner with a brass capped Lunde marker. All evidence of this corner was gone.

Describe or show any material discrepancy between the location of the restored corner and that of the corner previously restored or reestablished.

NONE KNOWN.


RECORD OF DURABLE WITNESS MONUMENTS

NO	DESCRIPTION	BEARING	DISTANCE
1	EX. 1" IRON PIPE ON S.-SIDE OF A WOOD FENCE POST	N 77°22'50"W (GRID)	80.72 FT.
2	SET AN 18" ROUNDHEAD BOLT 6'± OFF BLD'S CORNER	N. WESTERLY ±	31.62 FT.
3	SET A NAIL IN THE ROOT OF A 21" BOX ELDER	N 39° E (MAG.)	39.29 FT.
4	SET AN 18" ROUNDHEAD BOLT 6'± OFF SHED CORNER	S. EASTERLY ±	55.04 FT.

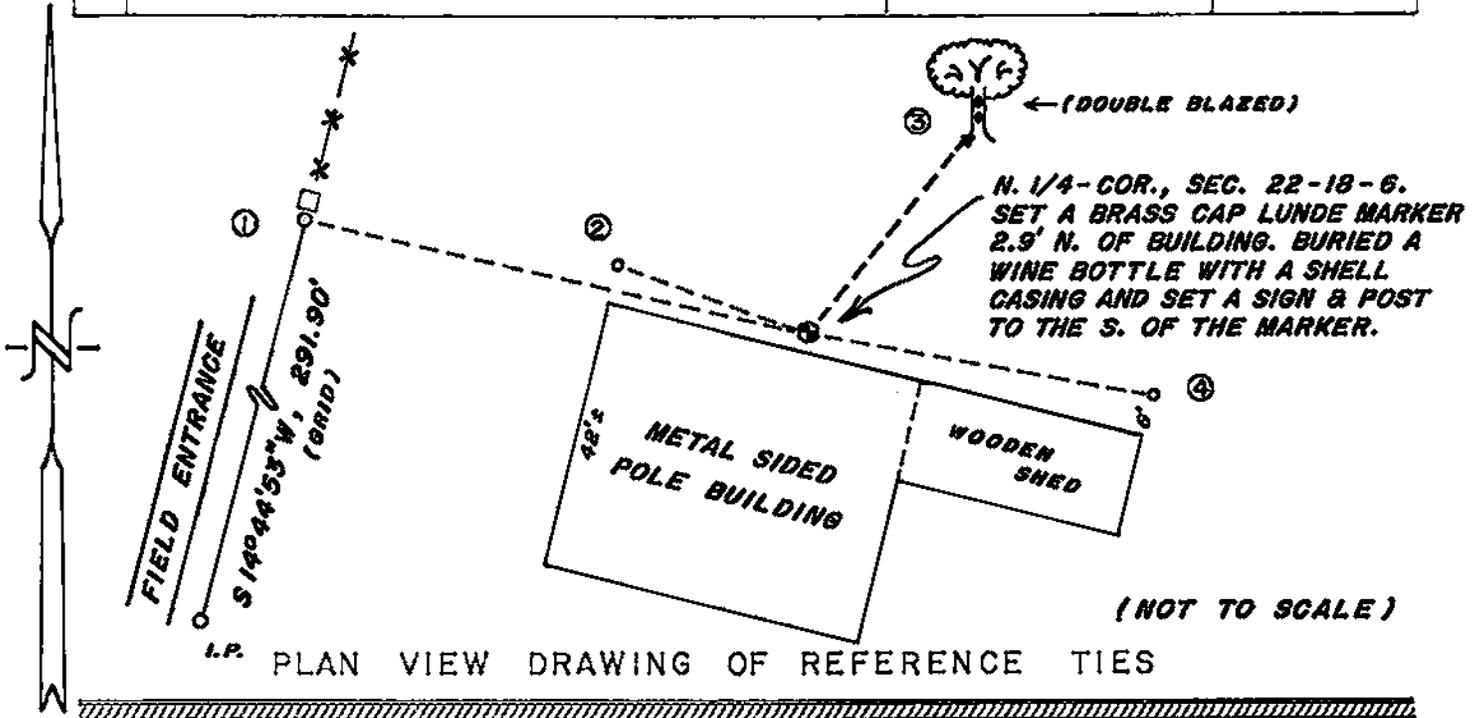

MAP SHOWING DISTANCE AND DIRECTION TO OTHER PUBLIC LAND SURVEY CORNERS USED FOR REESTABLISHING THE CORNER

(GRID BEARINGS & DISTANCES)
(GRID FACTOR: 0.99995086)
(NOT TO SCALE)

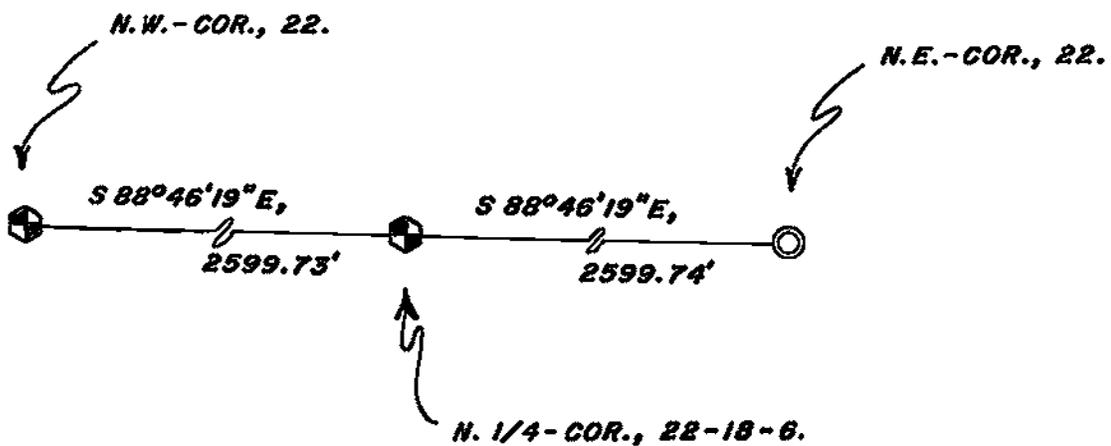

I, WILLIAM C. JUNG, COUNTY SURVEYOR
HEREBY CERTIFY THAT THE CORNER LOCATION SHOWN ON THIS RECORD WAS DETERMINED BY ME OR UNDER MY DIRECTION AND CONTROL AND THAT THIS U. S. PUBLIC LAND SURVEY MONUMENT RECORD IS CORRECT AND COMPLETE TO THE BEST OF MY KNOWLEDGE AND BELIEF.

William C. Jung
Signature

1/13/03
Date



Seal