


21806160000

## U. S. PUBLIC LAND SURVEY MONUMENT RECORD

SECTION 21 T 18 N, R 6 W, TOWN OF FARMINGTON

LA CROSSE COUNTY

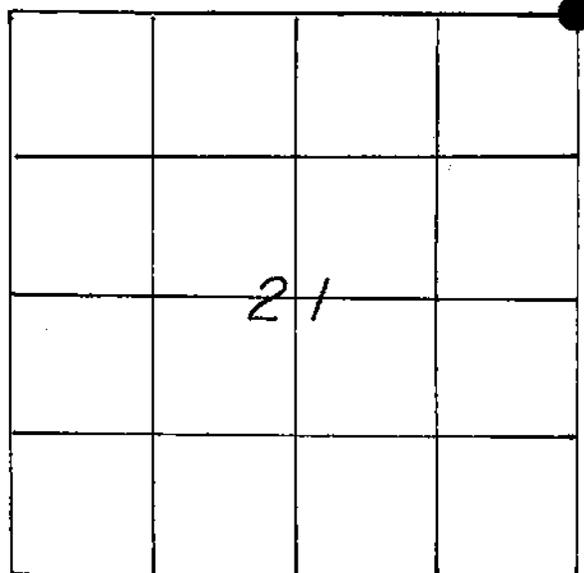

LOCATION OF LANDMARK

## WISCONSIN COORDINATE SYSTEM

North

East

Theta Angle

Horiz. Order

Vert. Order

## TYPE OF LANDMARK

~~RAILROAD SPIKE~~ Lunde Marker

BEARINGS ARE REFERENCED TO

ASSUMED

CREW: BILL JUNG, PERRY DAHL

DATE: 2-20-87

Revised: May 6, 1988

Describe any record evidence, monument evidence, testimonial evidence or any other material evidence you considered and whether the monument was found or restored through acceptance of an obliterated evidence location.


I found a railroad spike at the corner. This spike had been accepted and used as the corner in previous survey work. I accepted this occupied corner as the best available evidence of the original government corner position.

Describe or show any material discrepancy between the location of the restored corner and that of the corner previously restored or reestablished.

None known.


RECORD OF DURABLE WITNESS MONUMENTS

NO	DESCRIPTION	BEARING	DISTANCE
1	SOUTHWEST CORNER OF HOUSE	---	90.65'
3	1" IRON PIPE	---	37.14'
4	P.K. NAIL IN 8" UNBLAZED TAMARACK TREE	---	116.06'
6	SOUTHEAST CORNER OF HOUSE	---	85.5'

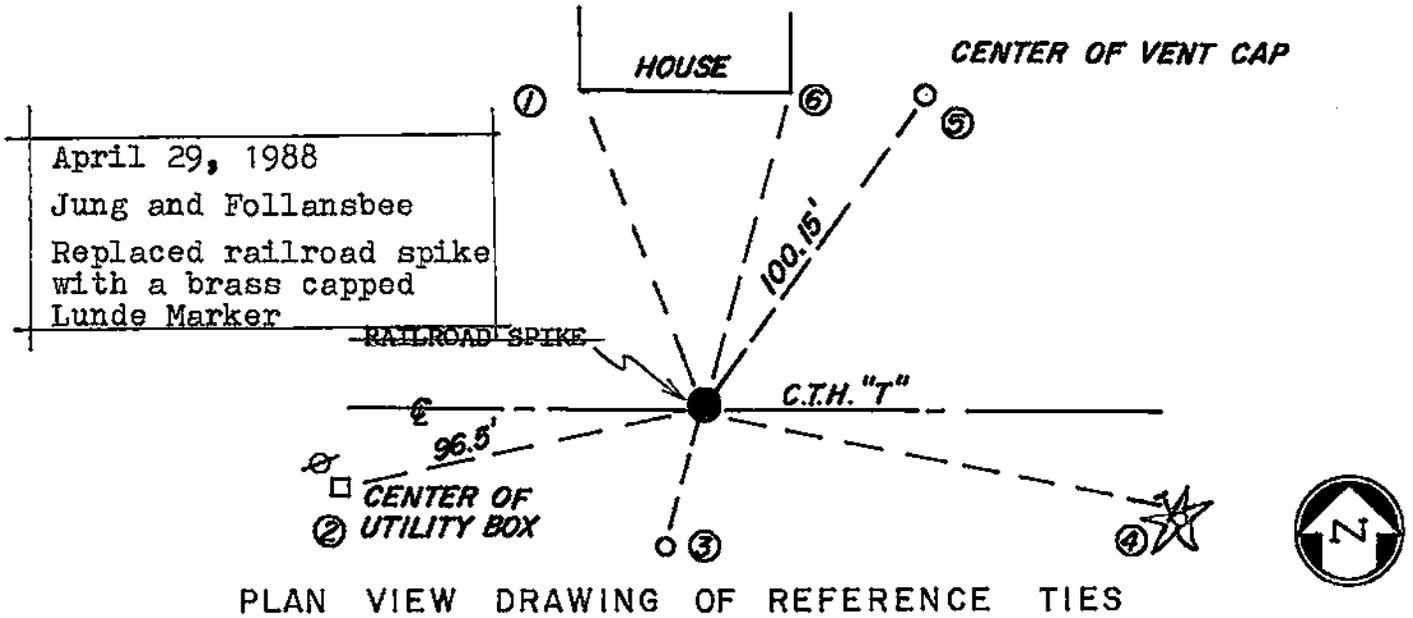

PLAN VIEW DRAWING OF REFERENCE TIES

MAP SHOWING DISTANCE AND DIRECTION TO OTHER PUBLIC LAND SURVEY CORNERS USED FOR REESTABLISHING THE CORNER

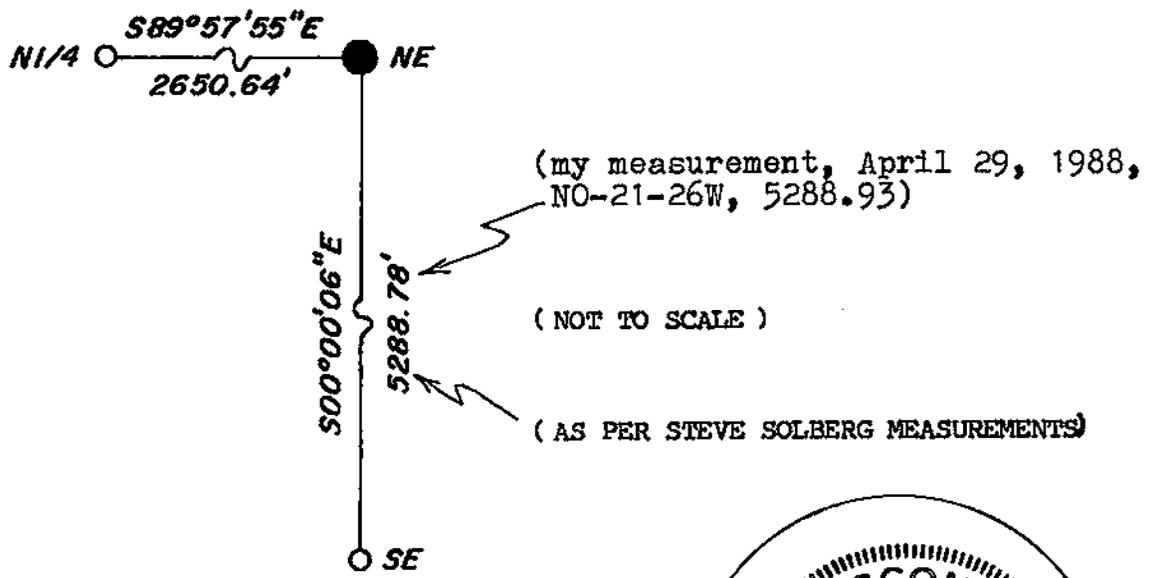

I, WILLIAM CHARLES JUNG, DEPUTY COUNTY SURVEYOR,  
 HEREBY CERTIFY THAT THE CORNER LOCATION SHOWN ON THIS RECORD  
 WAS DETERMINED BY ME OR UNDER MY DIRECTION AND CONTROL AND  
 THAT THIS U. S. PUBLIC LAND SURVEY MONUMENT RECORD IS CORRECT  
 AND COMPLETE TO THE BEST OF MY KNOWLEDGE AND BELIEF.

William C. Jung 2-24-87  
 Signature Date

Revised: May 6, 1988  
 w.c.j.

