


21806162000

U. S. PUBLIC LAND SURVEY MONUMENT RECORD

SECTION 15 T 18 N, R 6 W, TOWN OF FARMINGTON

LA CROSSE COUNTY

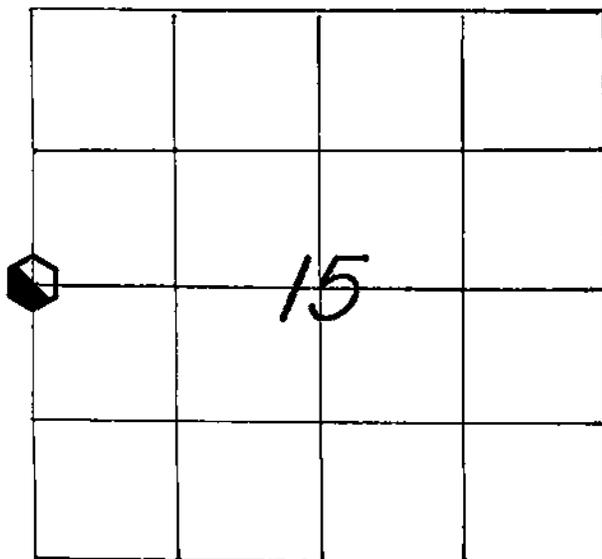

LOCATION OF LANDMARK

CREW: **WILLIAM C. JUNG**
PETER F. FOLLANSBEE
 DATE: **7/24/2006**

WISCONSIN COORDINATE SYSTEM	
North	743,802.864
East	1,681,348.607
Theta Angle	
Horiz. Order	
Vert. Order	
DATUM:	1983('91)
TYPE OF LANDMARK	
30° ALUMINUM BERNTSEN MARKER.	
BEARINGS ARE REFERENCED TO	
GRID NORTH AS PER SECTION DATA.	

Describe any record evidence, monument evidence, testimonial evidence or any other material evidence you considered and whether the monument was found or restored through acceptance of an obliterated evidence location.


My research indicates that the section line was at one time also a property line. Therefore I set the corner equidistant between the section corners and in the old North-South section line fence. I set a Berntsen marker at the corner.

Describe or show any material discrepancy between the location of the restored corner and that of the corner previously restored or reestablished.

I do not agree with the 1/4 corner position as shown by Clayton Solberg on his plat of survey, dated 5/21/81.


RECORD OF DURABLE WITNESS MONUMENTS

NO	DESCRIPTION	BEARING	DISTANCE
1	SET A NAIL IN S.E.-SIDE OF A 12" WHITE OAK	S 83° W	64.93 FT.
2	SET A NAIL IN S.W.-SIDE OF A 12" ELM	N 06° W	23.96 FT.
3	SET A NAIL IN N.W.-SIDE OF AN 1 1/2" ELM	N 41° E	17.92 FT.
4	SET A NAIL IN N.W.-SIDE OF A 28 1/2" WHITE OAK	SOUTH ±	SLOPE=40.40'

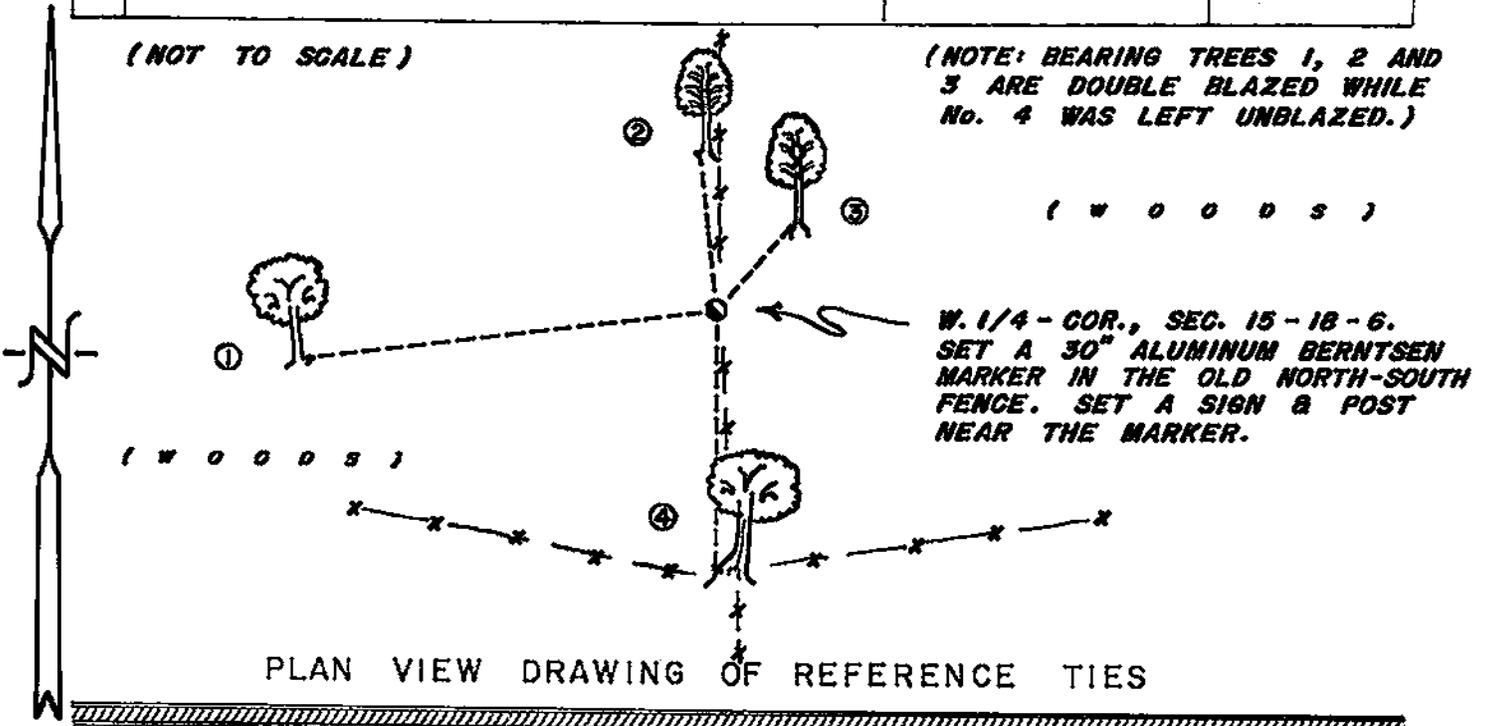


MAP SHOWING DISTANCE AND DIRECTION TO OTHER PUBLIC LAND SURVEY CORNERS USED FOR REESTABLISHING THE CORNER

(GRID BEARINGS AND DISTANCES)
(GRID FACTOR: 0.99996)
(NOT TO SCALE)

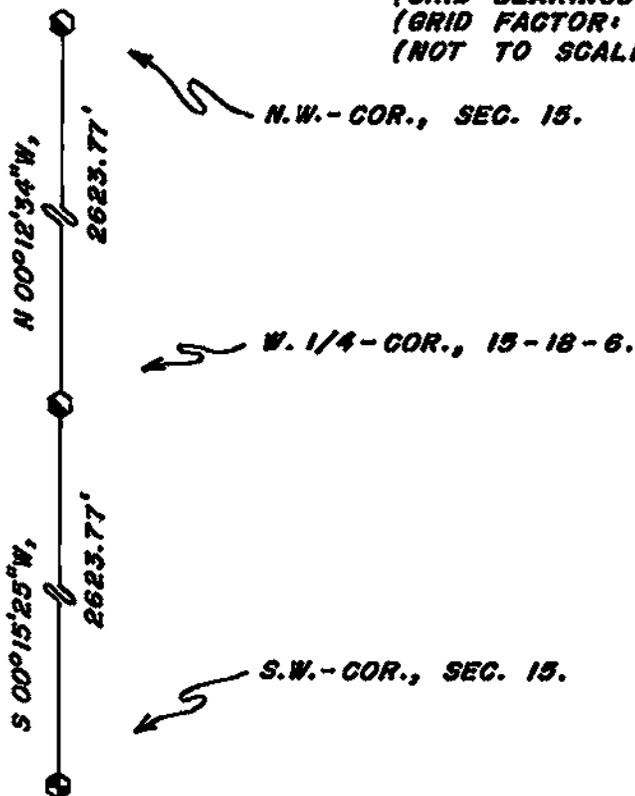

I, WILLIAM G. JUNG, COUNTY SURVEYOR
HEREBY CERTIFY THAT THE CORNER LOCATION SHOWN ON THIS RECORD WAS DETERMINED BY ME OR UNDER MY DIRECTION AND CONTROL AND THAT THIS U. S. PUBLIC LAND SURVEY MONUMENT RECORD IS CORRECT AND COMPLETE TO THE BEST OF MY KNOWLEDGE AND BELIEF.

William C. Jung 8/22/06
Signature Date

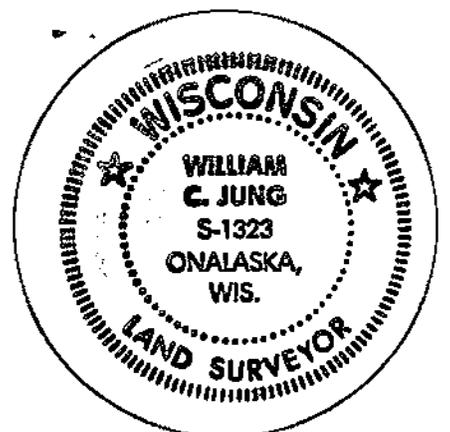

Seal