


## U. S. PUBLIC LAND SURVEY MONUMENT RECORD

SECTION 17 T 18 N, R 6 W, TOWN OF FARMINGTON  
LA CROSSE COUNTY

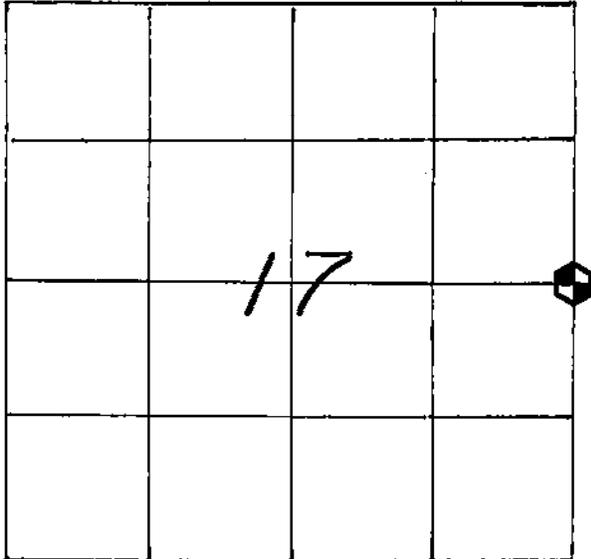

## WISCONSIN COORDINATE SYSTEM

North

East

Theta Angle

Horiz. Order

Vert. Order

## TYPE OF LANDMARK

BRASS CAP LUNDE MARKER.

BEARINGS ARE REFERENCED TO

ASSUMED NORTH.

## LOCATION OF LANDMARK

CREW: WILLIAM C. JUNG  
PETER F. FOLLANSBEE  
DATE: 9/12/1997

Describe any record evidence, monument evidence, testimonial evidence or any other material evidence you considered and whether the monument was found or restored through acceptance of an obliterated evidence location.


Steve Solberg had a calculated single proportionate position on this corner.  
Norm Hurlburt and I agree with this. I set a Lunde marker at the corner by use of Norm's survey points.

Describe or show any material discrepancy between the location of the restored corner and that of the corner previously restored or reestablished.

**NONE KNOWN.**

RECORD OF DURABLE WITNESS MONUMENTS  
MAGNETIC


NO	DESCRIPTION	BEARING	DISTANCE
1	SET A NAIL IN S.E.-SIDE 12-1/2" ELM (DOUBLE BLAZED)	N 48° E	9.79 FT.
2	SET A NAIL IN S.E.-SIDE 10" ELM (DOUBLE BLAZED)	N 72° E	13.59 FT.
3	SET A NAIL IN N.-SIDE 10" HICKORY (DOUBLE BLAZED)	S 87° E	47.80 FT.
4	SET A NAIL IN N.W.-SIDE 16-1/2" HICKORY (DOUBLE BLAZED)	S 05° W	88.84 FT.

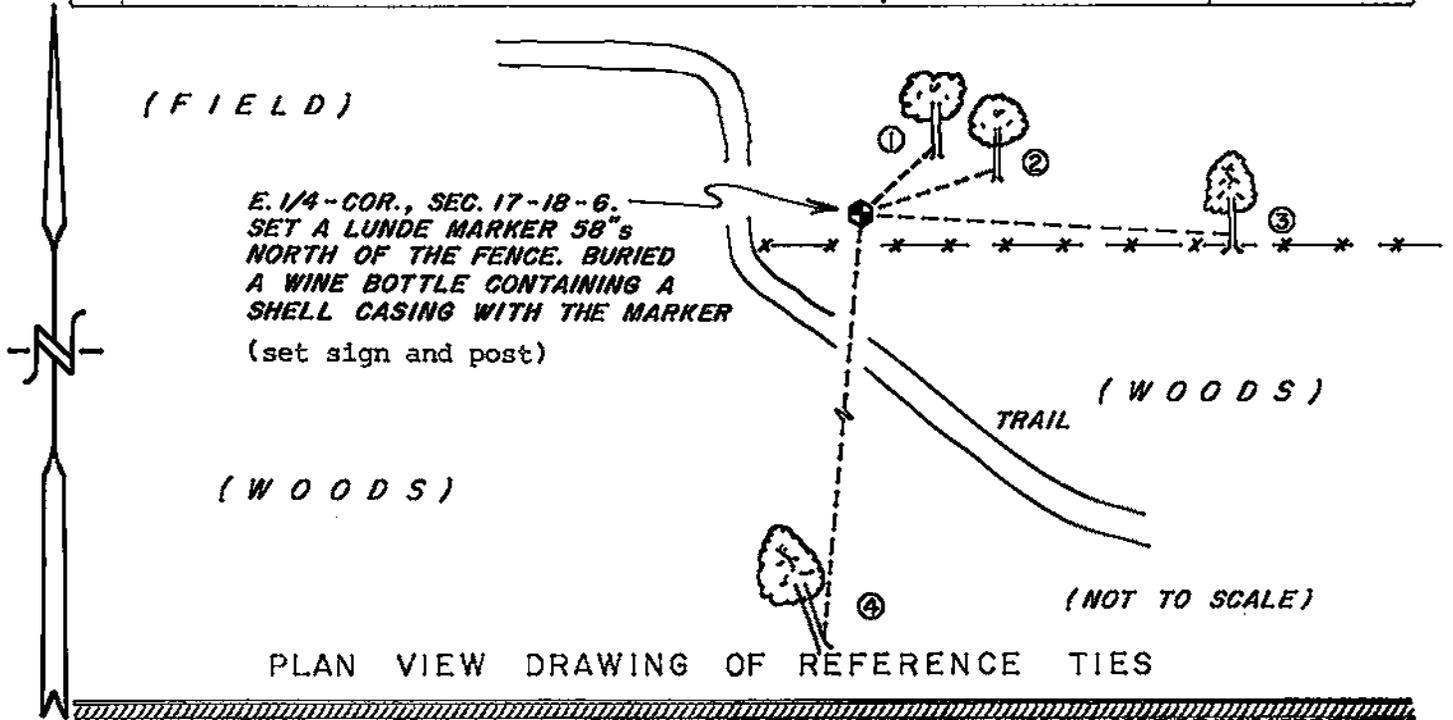

PLAN VIEW DRAWING OF REFERENCE TIES


MAP SHOWING DISTANCE AND DIRECTION TO OTHER PUBLIC LAND SURVEY CORNERS USED FOR REESTABLISHING THE CORNER

(HURLBURT MEASUREMENTS)  
(not to scale)

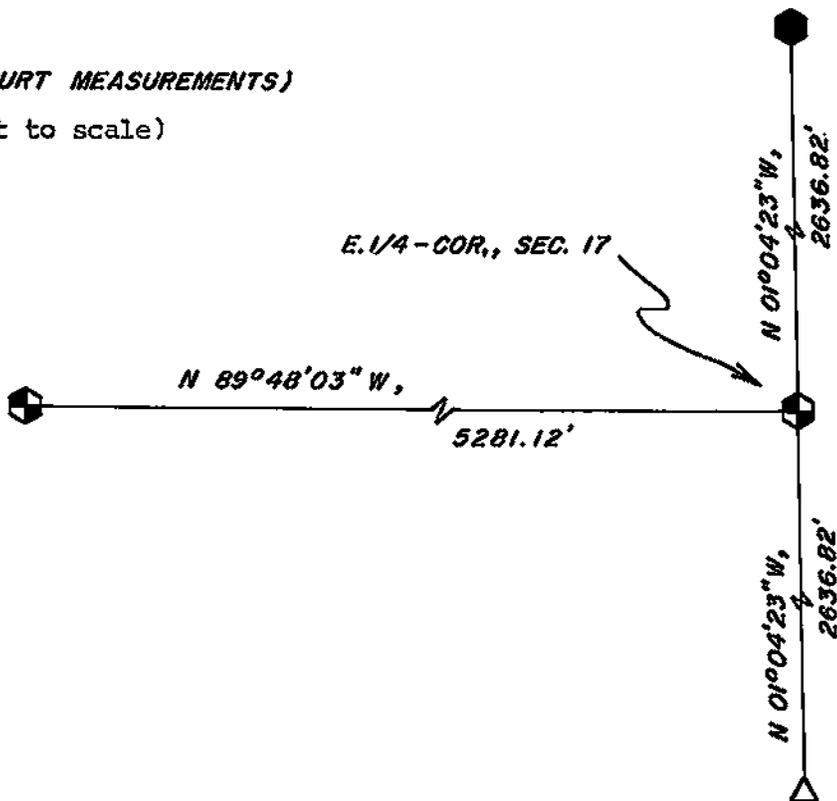

I, WILLIAM C. JUNG, COUNTY SURVEYOR  
HEREBY CERTIFY THAT THE CORNER LOCATION SHOWN ON THIS RECORD  
WAS DETERMINED BY ME OR UNDER MY DIRECTION AND CONTROL AND  
THAT THIS U. S. PUBLIC LAND SURVEY MONUMENT RECORD IS CORRECT  
AND COMPLETE TO THE BEST OF MY KNOWLEDGE AND BELIEF.

William C. Jung 1/21/98  
Signature Date

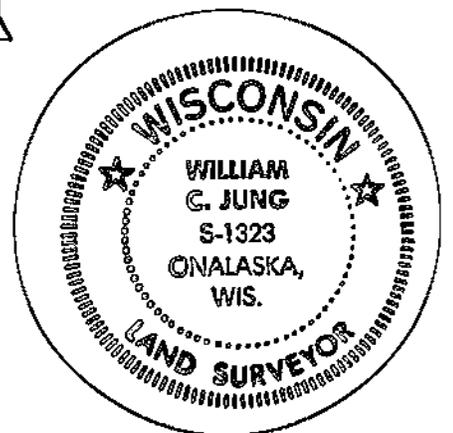

Seal