


U. S. PUBLIC LAND SURVEY MONUMENT RECORD

SECTION 20 T 18 N, R 6 W, TOWN OF Farmington

LA CROSSE COUNTY

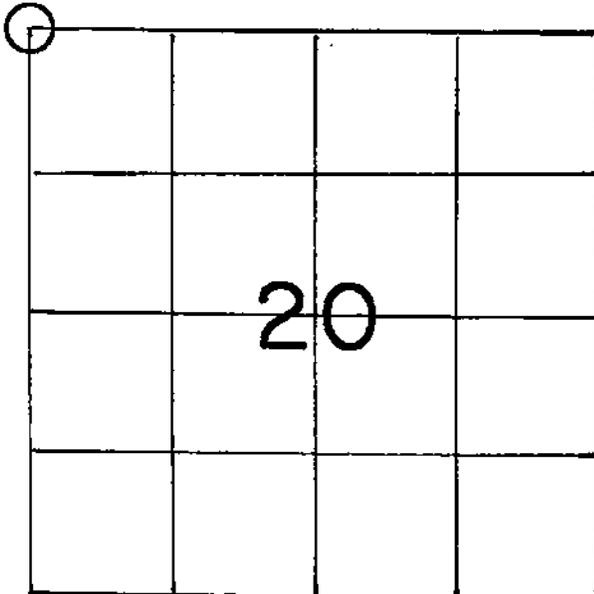

LOCATION OF LANDMARK

WISCONSIN COORDINATE SYSTEM
North
East
Theta Angle
Horiz. Order
Vert. Order

TYPE OF LANDMARK railroad spike over bent ¹/₈" iron pipe

BEARINGS ARE REFERENCED TO

Crew: William C. Jung
Peter F. Follansbee

Crew: William C. Jung
Peter F. Follansbee

Date: March 24, 1992

Date: August 2, 1999

Describe any record evidence, monument evidence, testimonial evidence or any other material evidence you considered and whether the monument was found or restored through acceptance of an obliterated evidence location.

I found an iron pipe at the occupied corner that had been used as the corner in previous surveys. I accepted this point as the best available evidence of the original government corner position.


The iron pipe was covered and disturbed by highway repaving. We set a railroad spike over the bent pipe.

Describe or show any material discrepancy between the location of the restored corner and that of the corner previously restored or reestablished.

None known.


RECORD OF DURABLE WITNESS MONUMENTS

NO	DESCRIPTION	BEARING	DISTANCE
1	Set $\frac{3}{8}$ "x18" rebar 3' South of fence	-----	42.16
2	Southwest corner of square steel post	-----	45.11
3	Set $\frac{3}{8}$ "x18" rebar 3' North of fence on Northwest side of 23" stump	Magnetic = S65°E	77.74
4	Set $\frac{3}{8}$ "x18" rebar 3' North of fence corner	-----	27.57

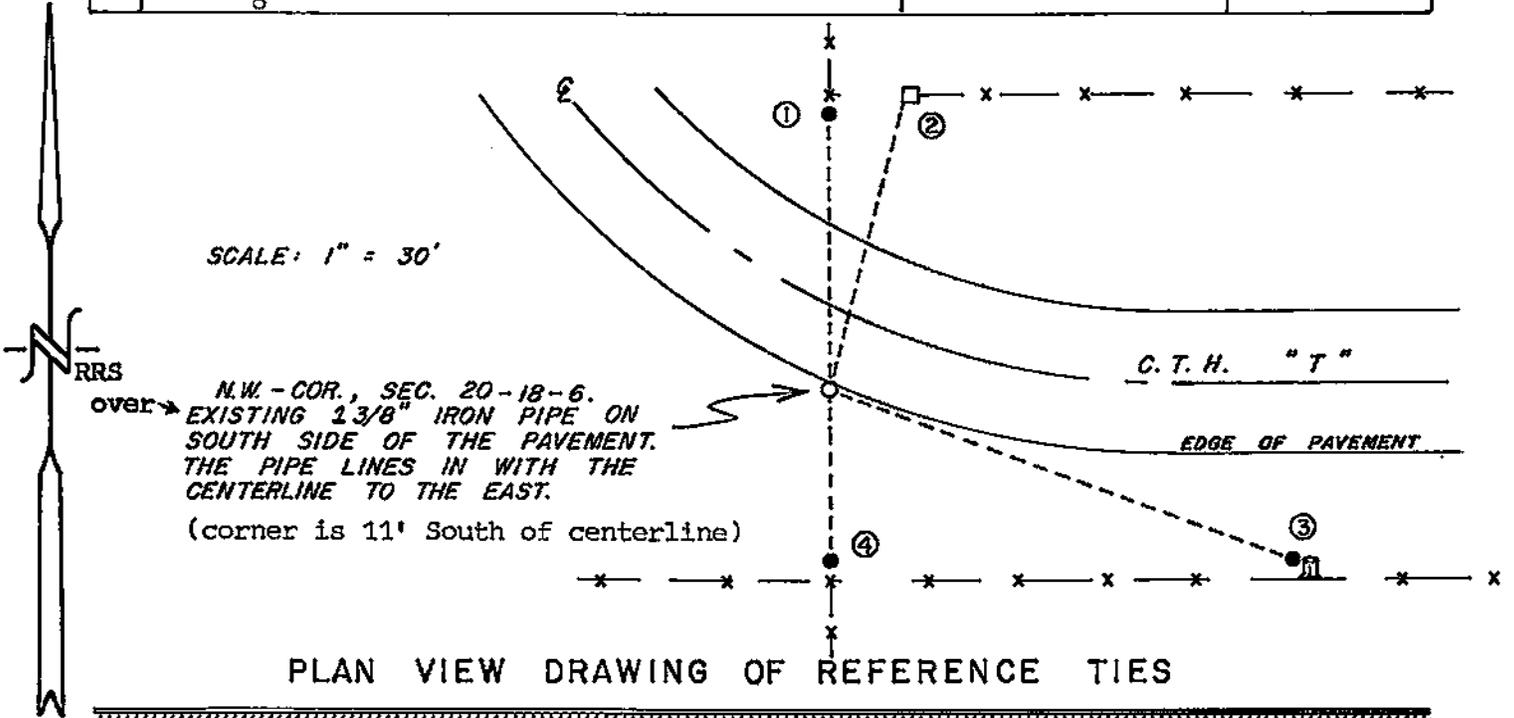

MAP SHOWING DISTANCE AND DIRECTION TO OTHER PUBLIC LAND SURVEY CORNERS USED FOR REESTABLISHING THE CORNER

(not to scale)

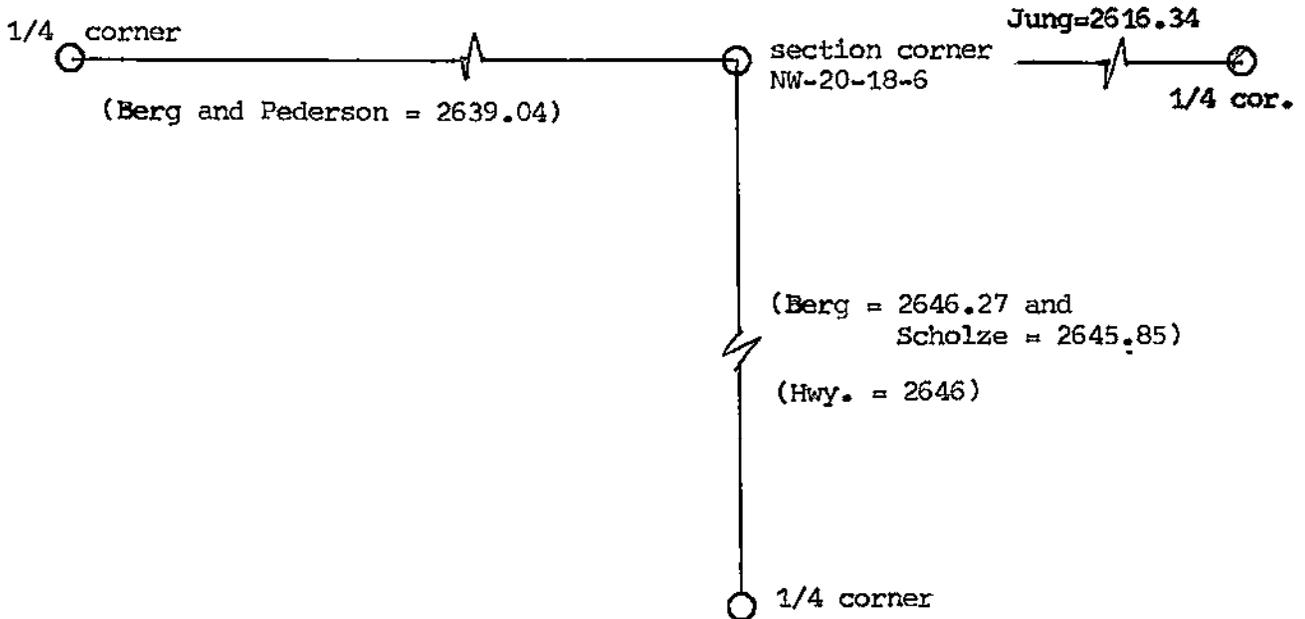

I, William C. Jung, Deputy County Surveyor,
 HEREBY CERTIFY THAT THE CORNER LOCATION SHOWN ON THIS RECORD
 WAS DETERMINED BY ME OR UNDER MY DIRECTION AND CONTROL AND
 THAT THIS U. S. PUBLIC LAND SURVEY MONUMENT RECORD IS CORRECT
 AND COMPLETE TO THE BEST OF MY KNOWLEDGE AND BELIEF.

William C. Jung June 3, 1992
 Signature Date

Revised: 9/27/99 *awey*



Seal