


U. S. PUBLIC LAND SURVEY MONUMENT RECORD

SECTION 30 T 18 N, R 6 W, TOWN OF FARMINGTON
LA CROSSE COUNTY

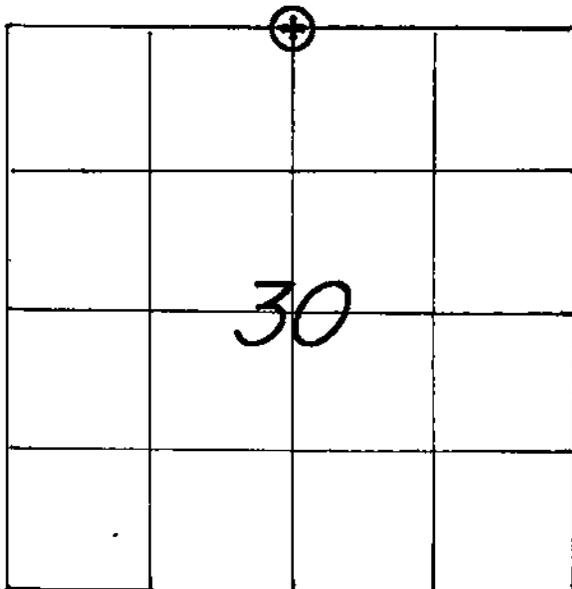

LOCATION OF LANDMARK

CREW: WILLIAM C. JUNG
PETER F. FOLLANSBEE
DATE: 8/02/2001

WISCONSIN COORDINATE SYSTEM

North

East

Theta Angle

Horiz. Order

Vert. Order

TYPE OF LANDMARK

3/4" x 30" IRON BAR WITH AN ALUMINUM CAP

BEARINGS ARE REFERENCED TO

ASSUMED NORTH AS PER SECTION DATA.

Describe any record evidence, monument evidence, testimonial evidence or any other material evidence you considered and whether the monument was found or restored through acceptance of an obliterated evidence location.


After Dick Berg surveyed out Section 30, he and I agreed that the corner should be set proportionately between the section corners and in the existing East-West fence. Berg set one of our standard bars and caps at the corner.

Describe or show any material discrepancy between the location of the restored corner and that of the corner previously restored or reestablished.


NONE KNOWN.

**RECORD OF DURABLE WITNESS MONUMENTS
ASSUMED NORTH**

NO	DESCRIPTION	BEARING	DISTANCE
1	SET A 3/4" x 30" IRON BAR WITH A RED PLASTIC CAP	WEST ±	24.58 FT.
2	EXISTING "MAG" NAIL IN ROAD CENTERLINE	EAST ±	28.76 FT.
3	EX. HEADLESS "MAG" NAIL IN ROAD CENTERLINE	S 29°13'08" E ±	50.88 FT.
4	EXISTING IRON PIPE IN THE FIELD.	S 52°28'25" E ±	73.08 FT.

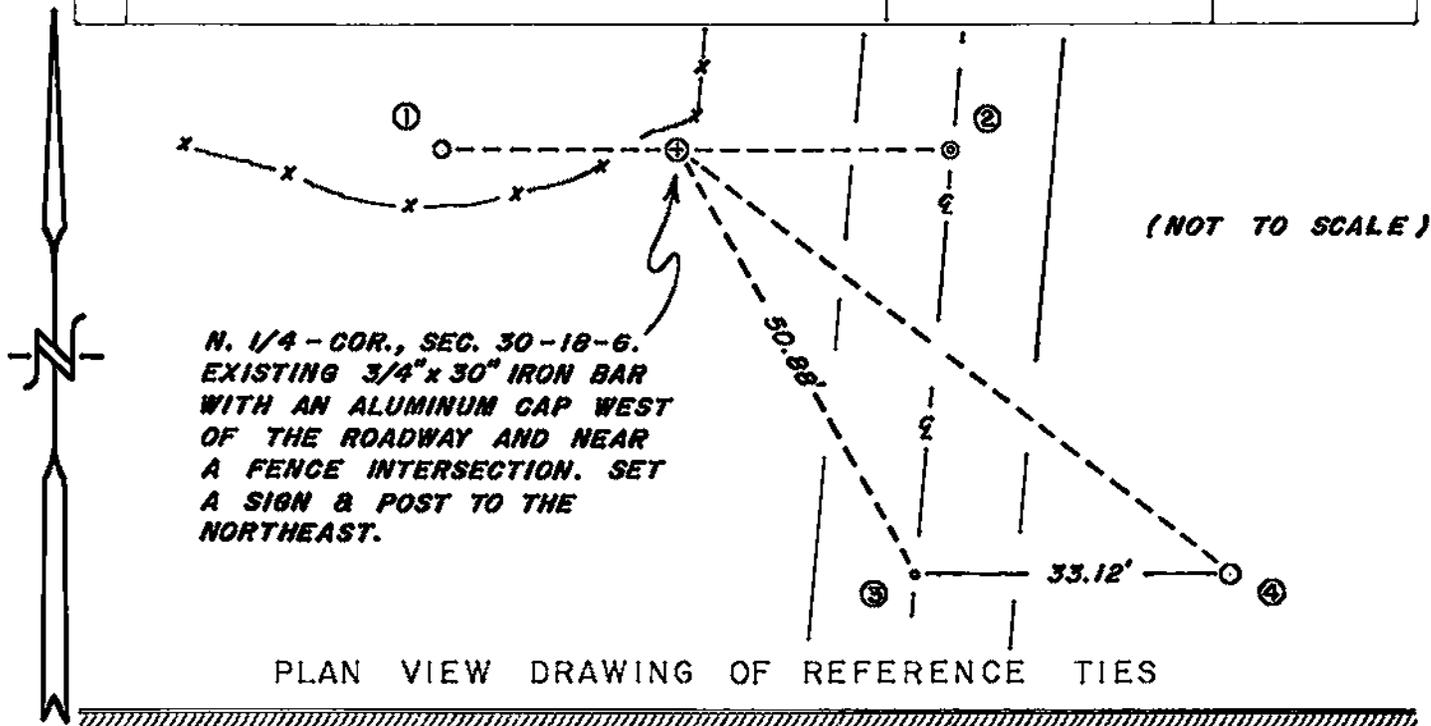


MAP SHOWING DISTANCE AND DIRECTION TO OTHER PUBLIC LAND SURVEY CORNERS USED FOR REESTABLISHING THE CORNER

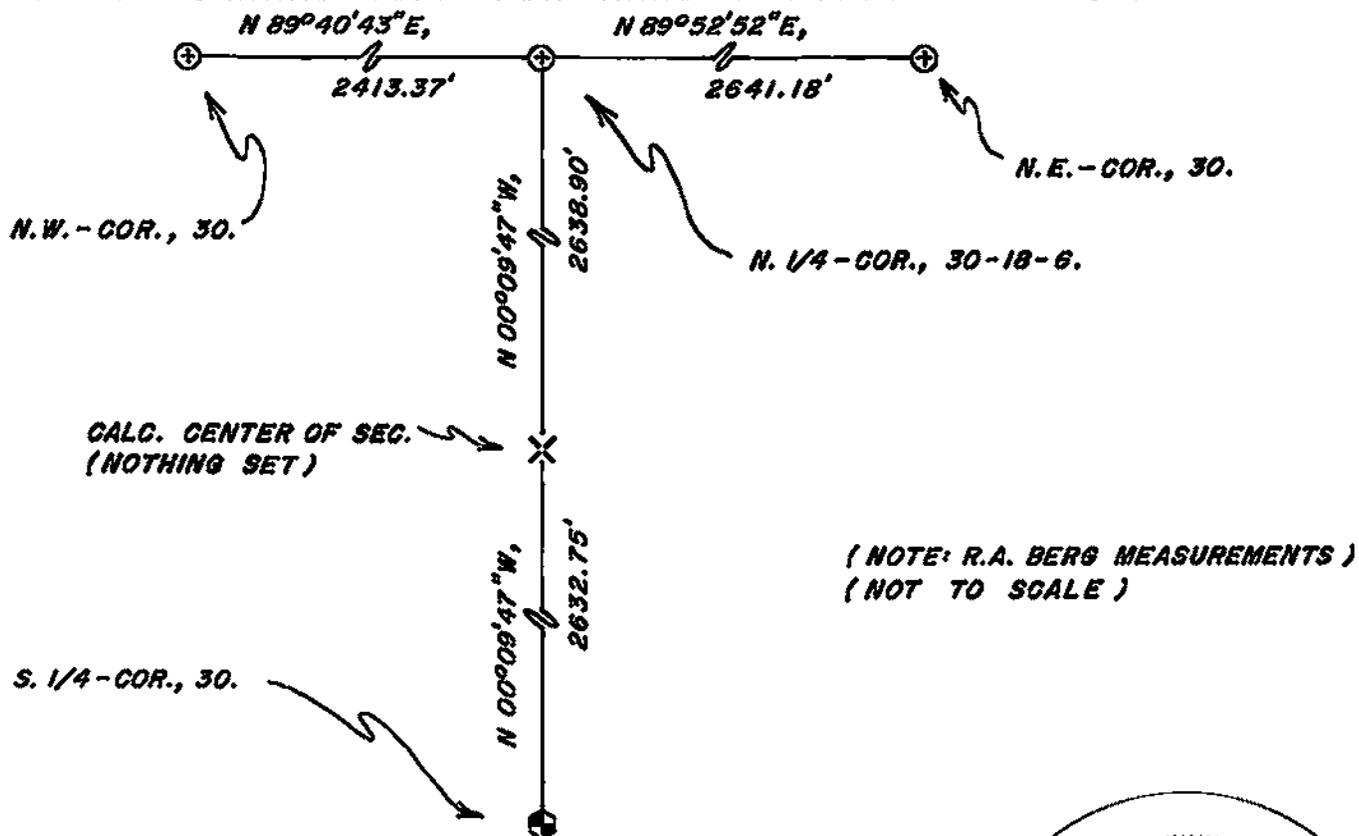

I, WILLIAM C. JUNG, COUNTY SURVEYOR
HEREBY CERTIFY THAT THE CORNER LOCATION SHOWN ON THIS RECORD
WAS DETERMINED BY ME OR UNDER MY DIRECTION AND CONTROL AND
THAT THIS U. S. PUBLIC LAND SURVEY MONUMENT RECORD IS CORRECT
AND COMPLETE TO THE BEST OF MY KNOWLEDGE AND BELIEF.

William C. Jung
Signature

11/20/01
Date

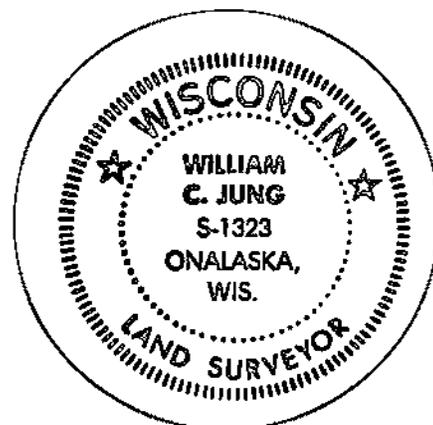

Seal