


21806192000

U. S. PUBLIC LAND SURVEY MONUMENT RECORD

SECTION 20 T 18 N, R 6 W, TOWN OF FARMINGTON

LA CROSSE COUNTY

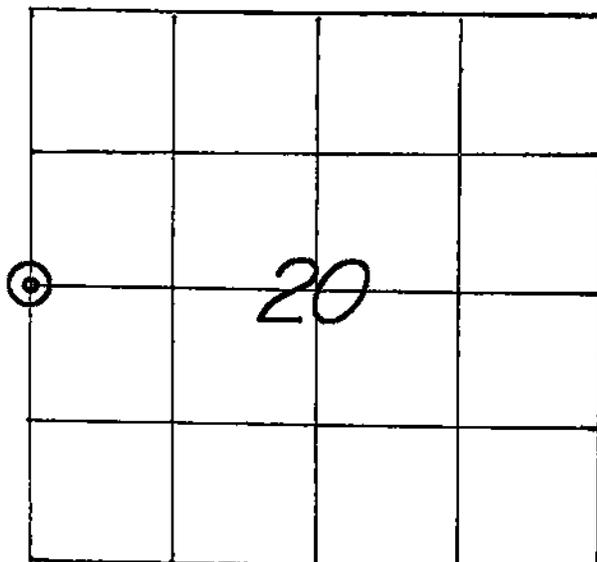

LOCATION OF LANDMARK

CREW: WILLIAM C. JUNG
 PETER F. FOLLANSBEE
 DATE: 5/04/2004

WISCONSIN COORDINATE SYSTEM

North

East

Theta Angle

Horiz. Order

Vert. Order

TYPE OF LANDMARK

P.K. NAIL OVER BURIED BERNTSEN MARKER.

BEARINGS ARE REFERENCED TO

Describe any record evidence, monument evidence, testimonial evidence or any other material evidence you considered and whether the monument was found or restored through acceptance of an obliterated evidence location.


Highway "D" was repaved last year. The Berntsen monument was covered up with the top possibly broken off. We could "hear" the monument below with the metal detector. The pavement is a very hard mix. We set a P.K. nail and cap over the monument.

Describe or show any material discrepancy between the location of the restored corner and that of the corner previously restored or reestablished.

NONE KNOWN.

RECORD OF DURABLE WITNESS MONUMENTS

NO	DESCRIPTION	MAGNETIC	
		BEARING	DISTANCE
1	EXISTING 1" IRON PIPE, FLUSH.	S 72° W	SLOPE = 134.29'
2	EXISTING 1" IRON PIPE, FLUSH.	N 76° W	SLOPE = 134.63'
3	EXISTING 1" IRON PIPE, FLUSH. 1' SOUTH OF ANGLE IRON.	N 29° E	59.30 FT.
4	SET A 3/4" x 30" IRON BAR WITH A RED PLASTIC CAP, FLUSH.	SOUTH	24.96 FT.

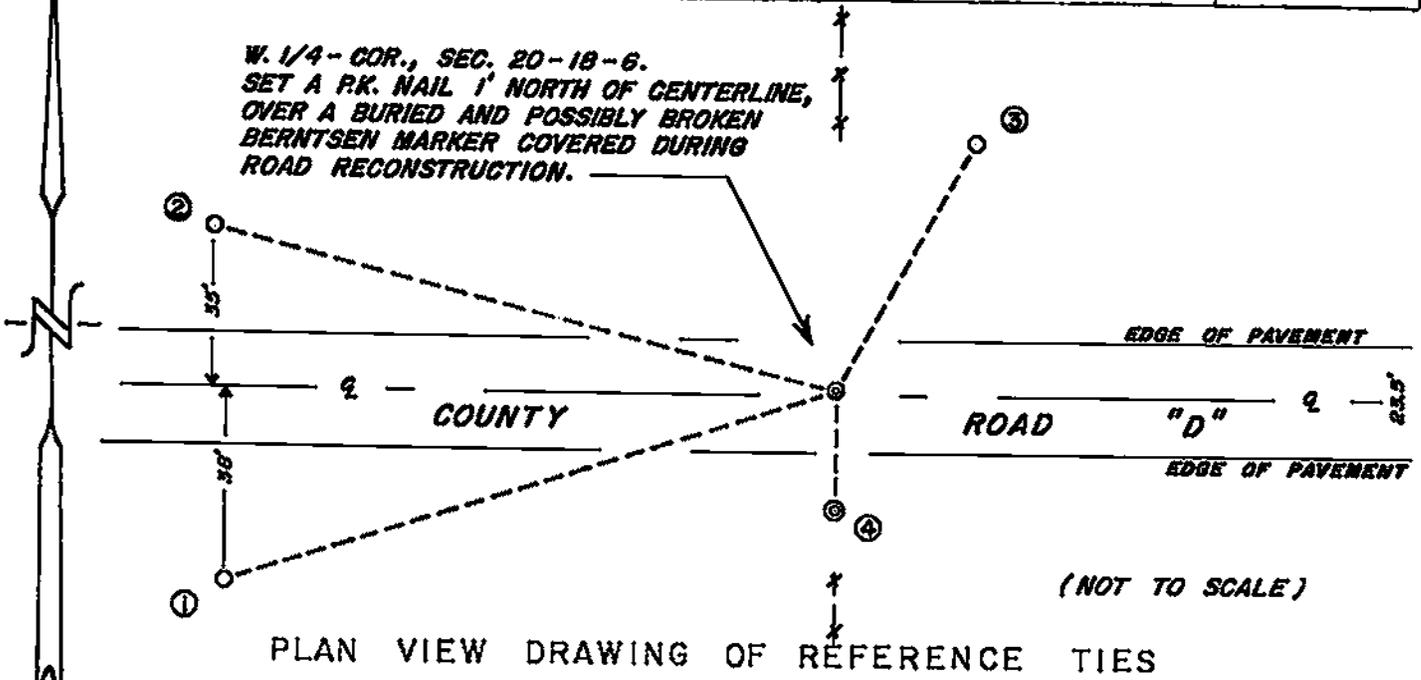

MAP SHOWING DISTANCE AND DIRECTION TO OTHER PUBLIC LAND SURVEY CORNERS USED FOR REESTABLISHING THE CORNER

No further section measurements were made by me at this time.

I, WILLIAM C. JUNG, COUNTY SURVEYOR
 HEREBY CERTIFY THAT THE CORNER LOCATION SHOWN ON THIS RECORD
 WAS DETERMINED BY ME OR UNDER MY DIRECTION AND CONTROL AND
 THAT THIS U. S. PUBLIC LAND SURVEY MONUMENT RECORD IS CORRECT
 AND COMPLETE TO THE BEST OF MY KNOWLEDGE AND BELIEF.

William C. Jung 12/23/04
 Signature Date



Seal

RECORD OF LAND CORNER PERPETUATION

No. _____

STATE OF WISCONSIN

County of Jackson ss.

I, Norman R. Hurlburt, hereby certify that the information shown hereon correctly describes the original corner, resurvey information, evidence found, type of monument found or placed, and witness monuments and accessories used to perpetuate the location of the original or established corner.

Dated this 23 day of December, 1983

at Black River Falls, Wisconsin.


Norman R. Hurlburt
Registered Land Surveyor S-1104
Title _____

COUNTY La Crosse		
TOWN Farmington		
HIGHWAY CTH "D"		
SECTION 20	TOWNSHIP 18N	RANGE 6W
TYPE OF LANDMARK 30" Berntsen Cast Aluminum Monument		


Date of Survey July 1983

Drafted by D.W. Melichar

Date Aug. 26, 1983

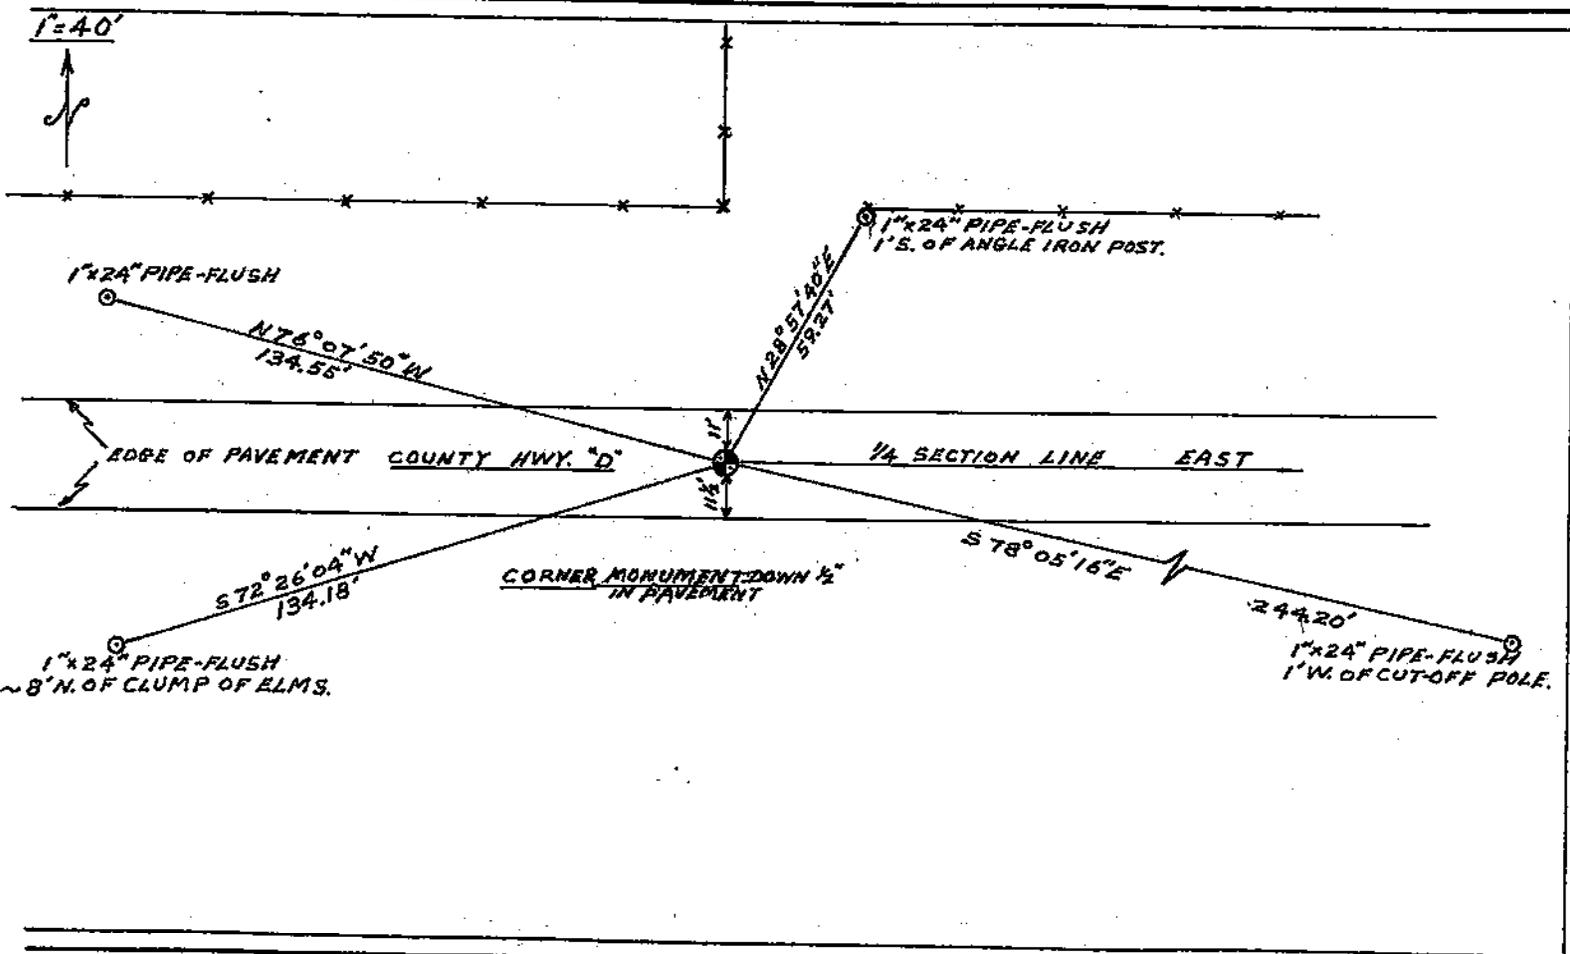

WISCONSIN COORDINATE SYSTEM	
North	Zone
East	
Elevation	Theta Angle
Vertical control order	
Horizontal control order	

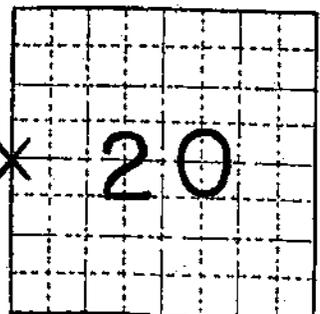

REMARKS: I found no record of any remonumentation of this corner. I found and accepted a PK nail on road centerline and fence lines. This point is less than a foot off midway between occupied section corners and about 9 feet west of a straight line. The line from here to the quarter corner east fits the old cemetery boundary very well.

LOCATION SKETCH
(Location of landmark indicated by "x")