


U. S. PUBLIC LAND SURVEY MONUMENT RECORD

SECTION 20 T 18 N, R 6 W, TOWN OF FARMINGTON

LA CROSSE COUNTY

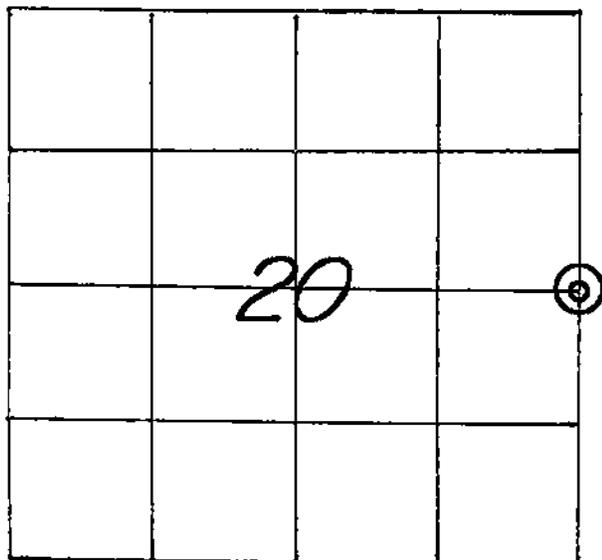

WISCONSIN COORDINATE SYSTEM

North

East

Theta Angle

Horiz. Order

Vert. Order

TYPE OF LANDMARK

P.K. NAIL.

BEARINGS ARE REFERENCED TO

LOCATION OF LANDMARK

CREW: WILLIAM G. JUNG
 PETER F. FOLLANSBEE
 DATE: 4/29/2004

Describe any record evidence, monument evidence, testimonial evidence or any other material evidence you considered and whether the monument was found or restored through acceptance of an obliterated evidence location.

Highway "D" was repaved in 2003. The Berntsen monument was covered up with the top possibly broken off. We could "hear" the monument below with the metal detector. The pavement is a very hard mix. We set a P.K. nail and cap over the monument.

Describe or show any material discrepancy between the location of the restored corner and that of the corner previously restored or reestablished.

NONE KNOWN.

RECORD OF LAND CORNER PERPETUATION

No. _____

STATE OF WISCONSIN

County of Jackson } ss.

I, Norman R. Hurlburt, hereby certify that the information shown hereon correctly describes the original corner, resurvey information, evidence found, type of monument found or placed, and witness monuments and accessories used to perpetuate the location of the original or established corner.

Dated this 23 day of December, 19 83

at Black River Falls, Wisconsin.


Norman R. Hurlburt
Registered Land Surveyor S-1104
Title

COUNTY La Crosse		
TOWN Farmington		
HIGHWAY CTH "D"		
SECTION 20	TOWNSHIP 18N	RANGE 6W
TYPE OF LANDMARK 30" Berntsen Cast Aluminum Monument		


Date of Survey July 1983

Drafted by D.W. Melichar

Date Aug. 26, 1983

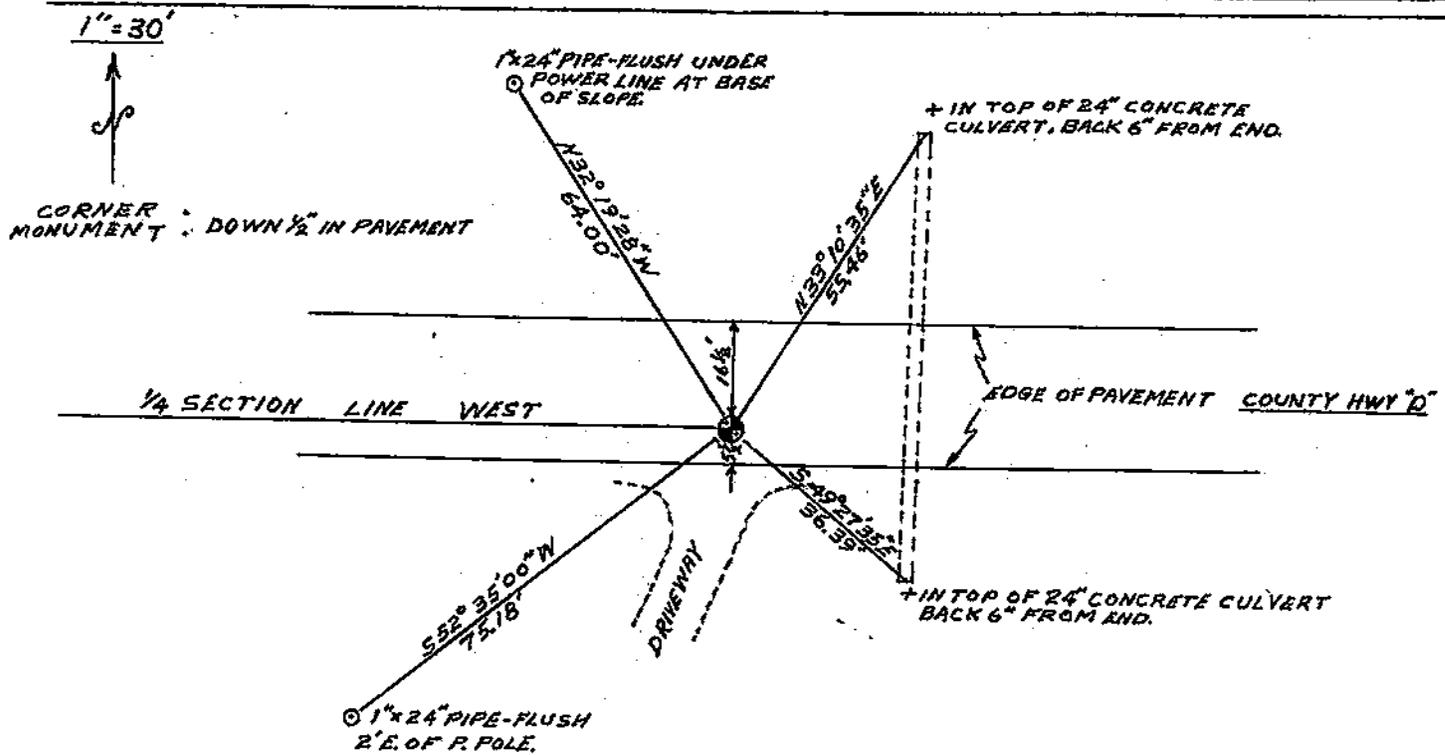

WISCONSIN COORDINATE SYSTEM	
North	Zone
East	
Elevation	Theta Angle
Vertical control order	
Horizontal control order	

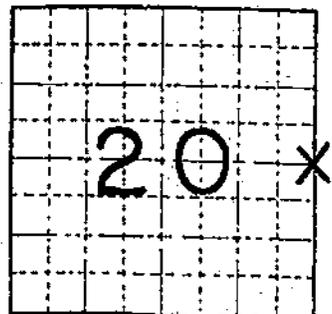

REMARKS: I found no record of remonumentation of this corner. Highway plans indicate the old centerline (assumed quarter line) was about 6 feet south of present centerline. This position agrees with distance from an occupied property corner 330 feet south, is within reason for 40 corners north and south, and the quarter line thus determined fits the old cemetery boundary very well. The fence line south, (Location of landmark indicated by "x") which was accepted, is about 2 feet west of line between occupied section corners.