


U. S. PUBLIC LAND SURVEY MONUMENT RECORD

SECTION 28 T 18 N, R 6 W, TOWN OF FARMINGTON
LA CROSSE COUNTY

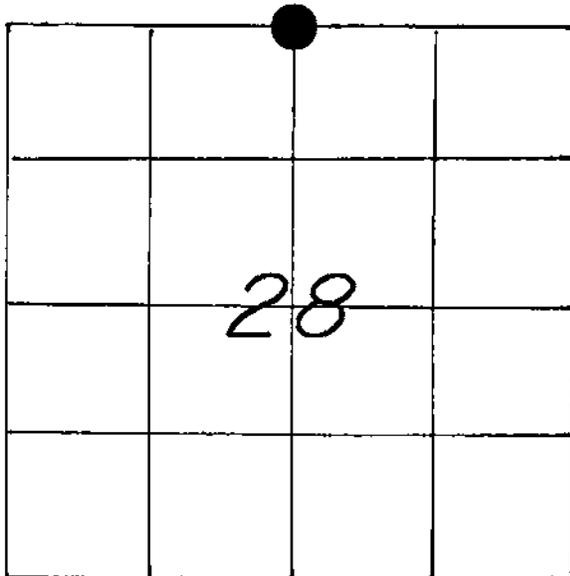

LOCATION OF LANDMARK

CREW: WILLIAM G. JUNG
PETER F. FOLLANSBEE
DATE: 10/10/1997

WISCONSIN COORDINATE SYSTEM

North

East

Theta Angle

Horiz. Order

Vert. Order

TYPE OF LANDMARK

2-1/2" x 30" IRON PIPE OVER EX. I.P.

BEARINGS ARE REFERENCED TO

ASSUMED NORTH.

Describe any record evidence, monument evidence, testimonial evidence or any other material evidence you considered and whether the monument was found or restored through acceptance of an obliterated evidence location.


We found the existing pipe of record "off plumb" in the creek. We plumbed up the existing pipe, set another pipe over it, and took new ties.

Describe or show any material discrepancy between the location of the restored corner and that of the corner previously restored or reestablished.


NONE KNOWN.

RECORD OF DURABLE WITNESS MONUMENTS
MAGNETIC

NO	DESCRIPTION	BEARING	DISTANCE
1	SET A NAIL IN THE S.-SIDE 36"± MAPLE	N 89° W	74.73 FT.
2	SET A NAIL IN THE S.E.-SIDE 17" MAPLE	N 61° E	26.04 FT.
3	EXISTING IRON PIPE	N 88° E	47.66 FT.
4	SET A NAIL IN THE S.E.-SIDE 18" BOX ELDER	S 30° W	10.46 FT.

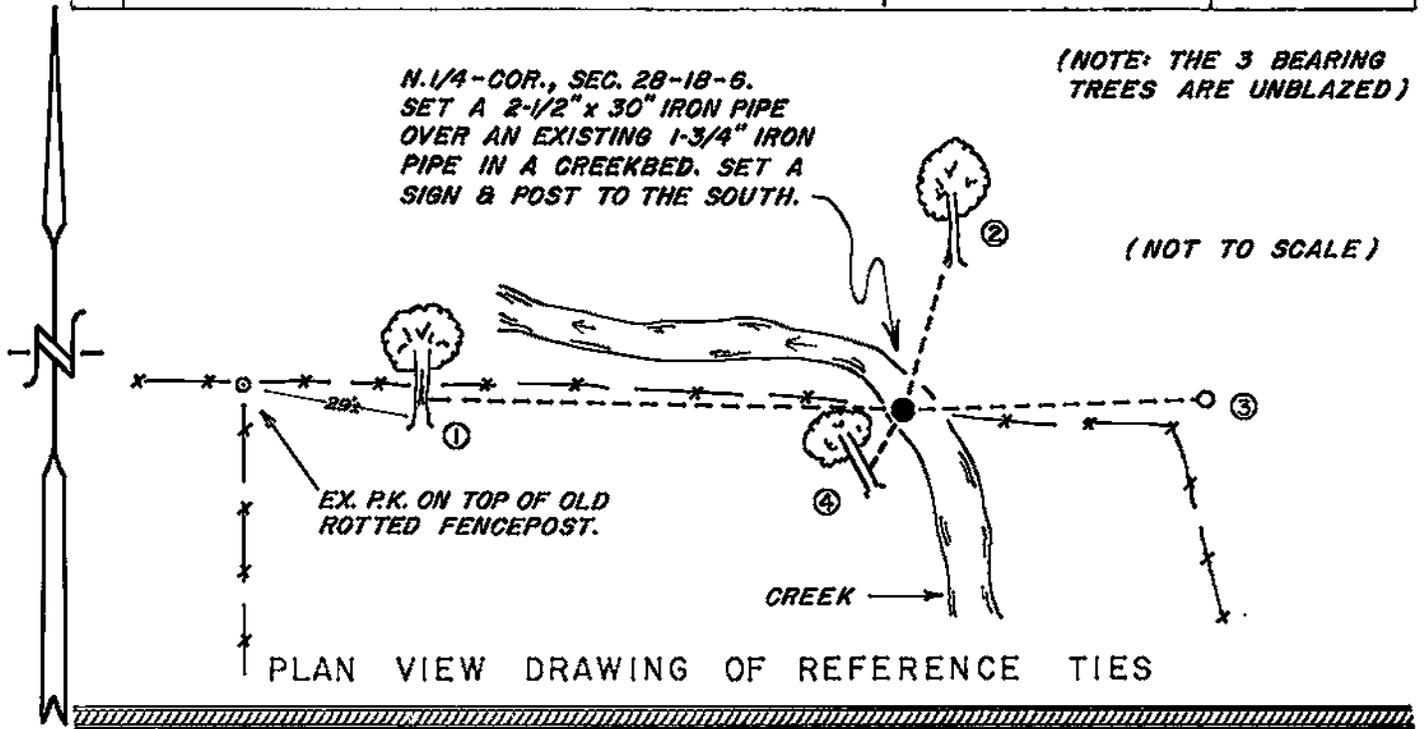

MAP SHOWING DISTANCE AND DIRECTION TO OTHER PUBLIC LAND SURVEY CORNERS USED FOR REESTABLISHING THE CORNER

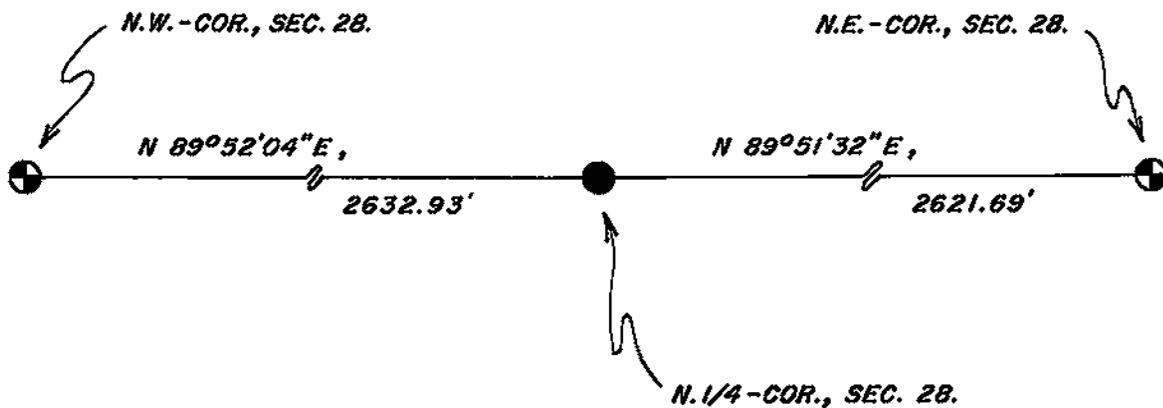

I, WILLIAM C. JUNG, COUNTY SURVEYOR
HEREBY CERTIFY THAT THE CORNER LOCATION SHOWN ON THIS RECORD
WAS DETERMINED BY ME OR UNDER MY DIRECTION AND CONTROL AND
THAT THIS U. S. PUBLIC LAND SURVEY MONUMENT RECORD IS CORRECT
AND COMPLETE TO THE BEST OF MY KNOWLEDGE AND BELIEF.

William C. Jung
Signature

11/12/97
Date




Seal

U. S. PUBLIC LAND SURVEY MONUMENT RECORD

SECTION 21 T 18 N, R 6 W, TOWN OF FARMINGTON

LA CROSSE COUNTY

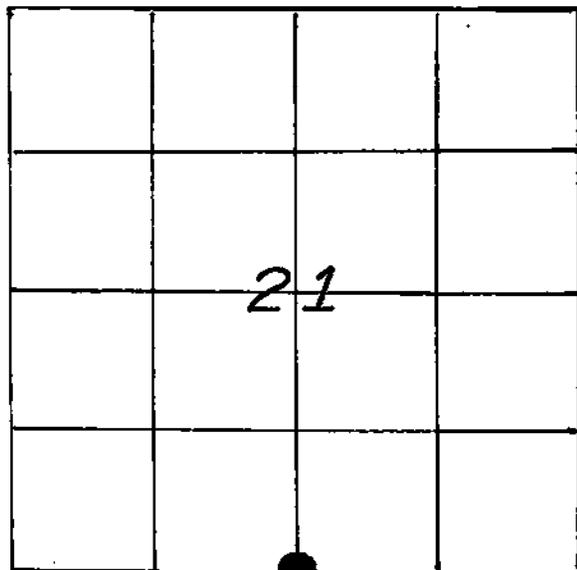

LOCATION OF LANDMARK

WISCONSIN COORDINATE SYSTEM
North
East
Theta Angle
Horiz. Order
Vert. Order
TYPE OF LANDMARK
1 1/4" Iron Pipe
BEARINGS ARE REFERENCED TO ASSUMED

CREW: Rodney Maxwell, Dwayne Hefner

DATE: 4 October, 1995

Describe any record evidence, monument evidence, testimonial evidence or any other material evidence you considered and whether the monument was found or restored through acceptance of an obliterated evidence location.


I found a 1 1/4" iron pipe at the corner. This pipe had been shown on previous survey maps and made reference to on tie sheet for the C 1/4 corner. Pipe also fit occupied fence lines. I accepted this pipe as best available evidence of the original government corner position.

Describe or show any material discrepancy between the location of the restored corner and that of the corner previously restored or reestablished.


None known.

RECORD OF DURABLE WITNESS MONUMENTS

NO	DESCRIPTION	BEARING	DISTANCE
1	15" MAPLE	N61°06'E	26.09'
2	3/4" Iron Pipe Found	N89°23'08"E	48.00'
3	12" Elm	S25°28'14"W	9.77'
4	36" Maple	WEST +/-	80'+/-

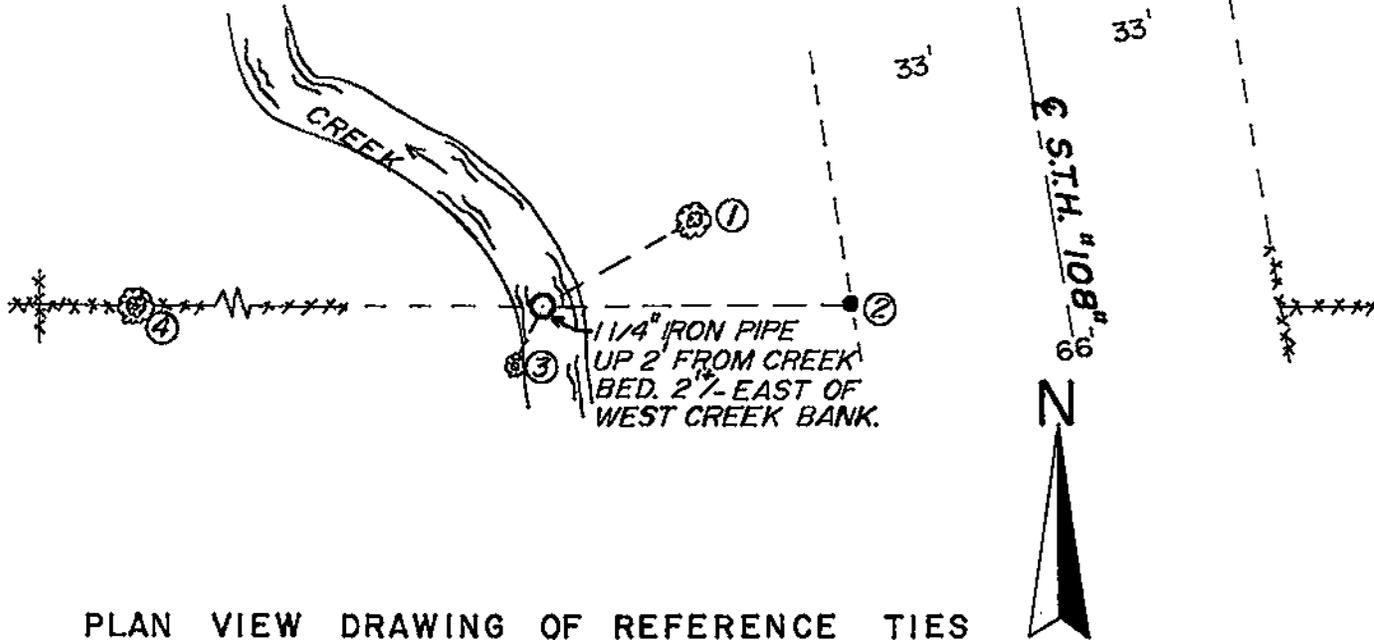


MAP SHOWING DISTANCE AND DIRECTION TO OTHER PUBLIC LAND SURVEY CORNERS USED FOR REESTABLISHING THE CORNER

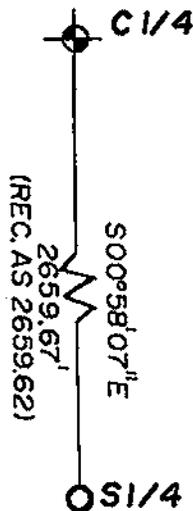

I, Rodney H. Maxwell, Registered Land Surveyor,
 HEREBY CERTIFY THAT THE CORNER LOCATION SHOWN ON THIS RECORD
 WAS DETERMINED BY ME OR UNDER MY DIRECTION AND CONTROL AND
 THAT THIS U. S. PUBLIC LAND SURVEY MONUMENT RECORD IS CORRECT
 AND COMPLETE TO THE BEST OF MY KNOWLEDGE AND BELIEF.

Rodney H. Maxwell
 Signature

Jan. 18, 1996
 Date

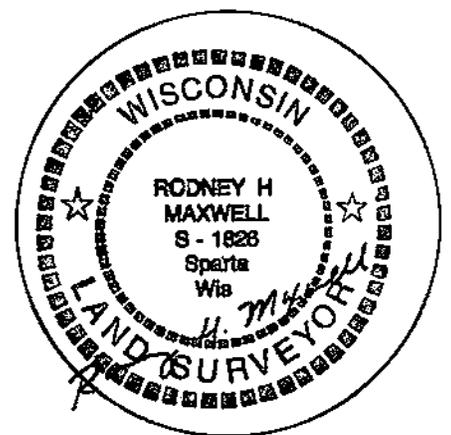

Seal