


U. S. PUBLIC LAND SURVEY MONUMENT RECORD

SECTION 21 T 18 N, R 6 W, TOWN OF FARMINGTON
 LA CROSSE COUNTY

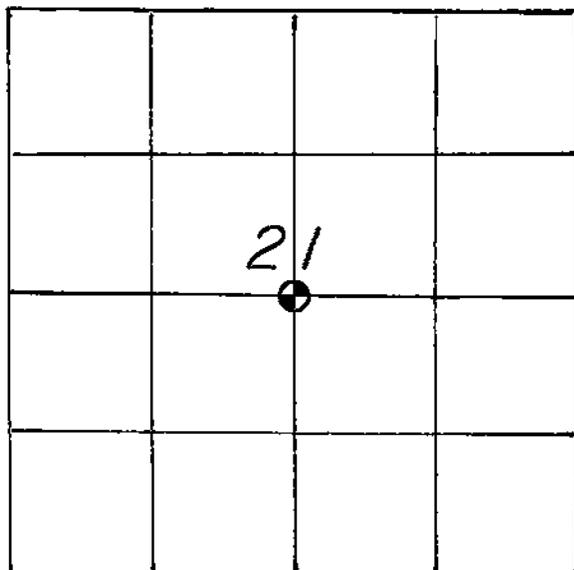

LOCATION OF LANDMARK
 CREW: BILL JUNG, PERRY DAHL

DATE: 2-20-87

4/29/04

Revised: 12-18-87

Jung and
 Follansbee

WISCONSIN COORDINATE SYSTEM

North 738,594.376 83(91)

East 1,678,669.814

Theta Angle

Horiz. Order

Vert. Order

TYPE OF LANDMARK P.K. nail and cap
~~4" IRON PIPE~~ over Harrison over pipe

BEARINGS ARE REFERENCED TO

ASSUMED

5/22/87 Jung and Dahl

I drove down the iron pipe and set a 2 1/2" x 12" "baby" Harrison marker over the top of it. The Harrison is down 1/2".

Describe any record evidence, monument evidence, testimonial evidence or any other material evidence you considered and whether the monument was found or restored through acceptance of an obliterated evidence location. *wef*

I found an iron pipe at the occupied center of section. This pipe and location have been used as the C₄ corner in several previous surveys including plats, highway surveys, plats of survey, and CSM's. Due to the field conditions and evidence, I accepted this pipe as the C₄ corner.


4/29/04 - The road to the West was repaved in 2003 and the "baby" Harrison was covered up. We set a P.K. nail and cap over it. *wef*

Describe or show any material discrepancy between the location of the restored corner and that of the corner previously restored or reestablished.

The occupied C₄ corner is not at the intersection of the 1/4 lines.


RECORD OF DURABLE WITNESS MONUMENTS

NO	DESCRIPTION	BEARING	DISTANCE
1	1 1/8" IRON ROD	---	44.66 44.63
2	set a PK nail at the NE corner of the gutter	S60°W ±	39.42
4	(the walk has cracked off) CORNER OF CONCRETE BUILDING WALKWAY	---	47.16 47.24
3	CENTER OF WATER VALVE	---	27.32 27.29

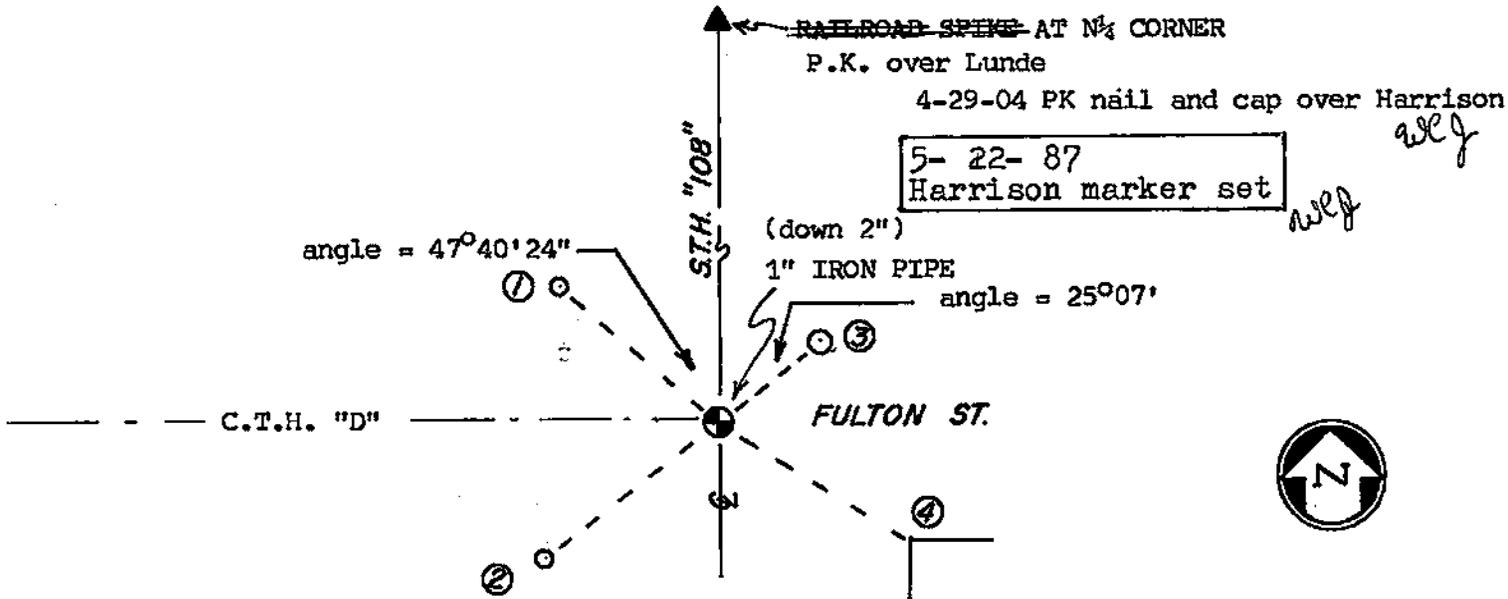

PLAN VIEW DRAWING OF REFERENCE TIES

MAP SHOWING DISTANCE AND DIRECTION TO OTHER PUBLIC LAND SURVEY CORNERS USED FOR REESTABLISHING THE CORNER

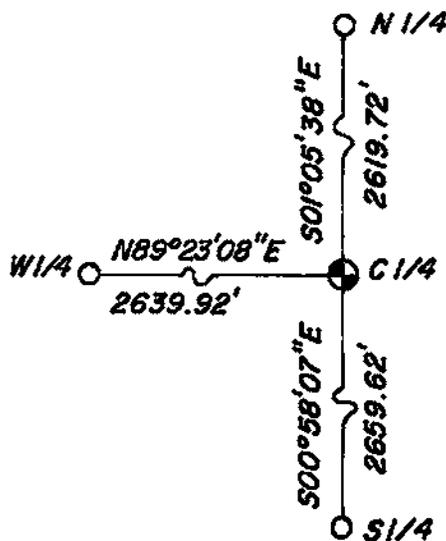

(NOT TO SCALE)

(AS PER NORM HURLBURT MEASUREMENTS)


I, WILLIAM CHARLES JUNG, DEPUTY COUNTY SURVEYOR,
HEREBY CERTIFY THAT THE CORNER LOCATION SHOWN ON THIS RECORD
WAS DETERMINED BY ME OR UNDER MY DIRECTION AND CONTROL AND
THAT THIS U. S. PUBLIC LAND SURVEY MONUMENT RECORD IS CORRECT
AND COMPLETE TO THE BEST OF MY KNOWLEDGE AND BELIEF.

William C. Jung
Signature

Revised: 12-18-87
2-24-87

Date

Revised: 1-24-05

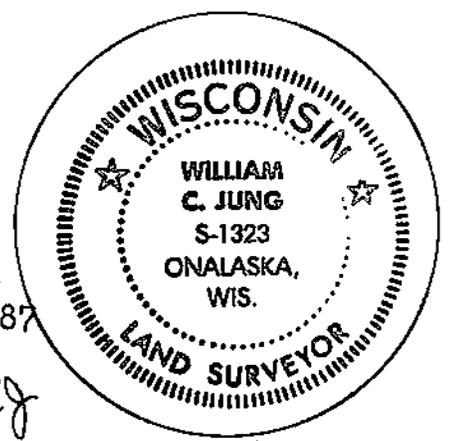

Seal