


U. S. PUBLIC LAND SURVEY MONUMENT RECORD

SECTION 22 T 18 N, R 6 W, TOWN OF FARMINGTON
LA CROSSE COUNTY

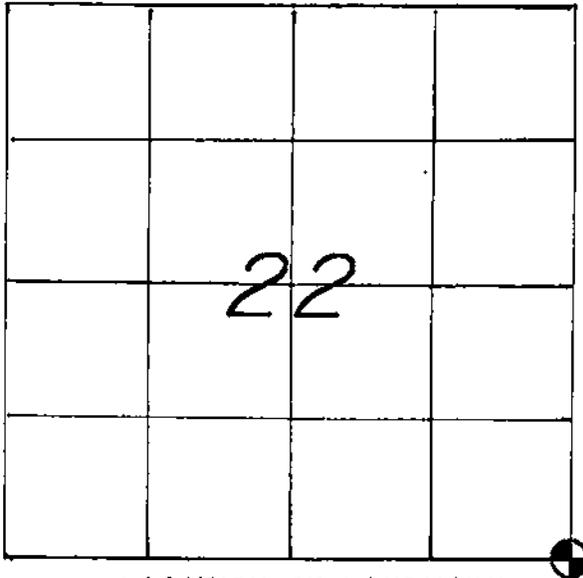

LOCATION OF LANDMARK

CREW: WILLIAM C. JUNG
PETER F. FOLLANSBEE
DATE: 10/29/1997

WISCONSIN COORDINATE SYSTEM

North

East

Theta Angle

Horiz. Order

Vert. Order

TYPE OF LANDMARK

BRASS CAP LUNDE MARKER.

BEARINGS ARE REFERENCED TO

ASSUMED NORTH.


Describe any record evidence, monument evidence, testimonial evidence or any other material evidence you considered and whether the monument was found or restored through acceptance of an obliterated evidence location.

I found a good old North-South fence at the base of the ridge to the North, projected this fence South, and intersected it with the line fence to the West. After reviewing my section traverse and computations, I accepted this occupied corner as the best available evidence of the original government corner location. There is an old South line fence (down) 23 feet to the West, but I could not accept it. I set a Lunde at the corner. Describe or show any material discrepancy between the location of the restored corner and that of the corner previously restored or reestablished.


NONE KNOWN.

RECORD OF DURABLE WITNESS MONUMENTS
MAGNETIC

NO	DESCRIPTION	BEARING	DISTANCE
1	SET A P.K. NAIL IN THE S.W.-SIDE 13" WHITE OAK	N 48° W	25.00 FT.
2	SET A NAIL IN THE S.W.-SIDE 8" ASPEN	N 17° W	20.77 FT.
3	SET A NAIL IN THE N.W.-SIDE 17" WHITE OAK	S 21° W	26.38 FT.
4	SET A NAIL IN THE N.W.-SIDE 17" WHITE OAK	S 38° W	67.03 FT.

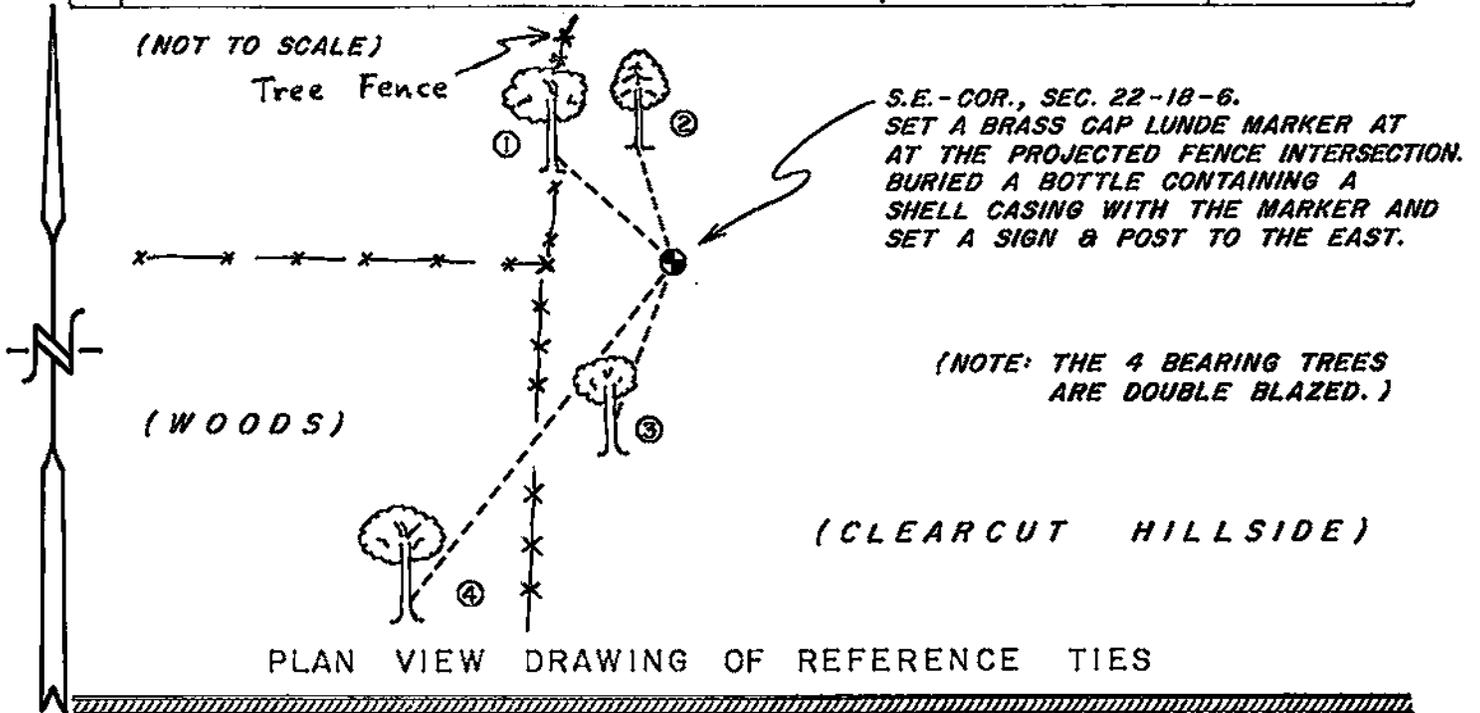

MAP SHOWING DISTANCE AND DIRECTION TO OTHER PUBLIC LAND SURVEY CORNERS USED FOR REESTABLISHING THE CORNER

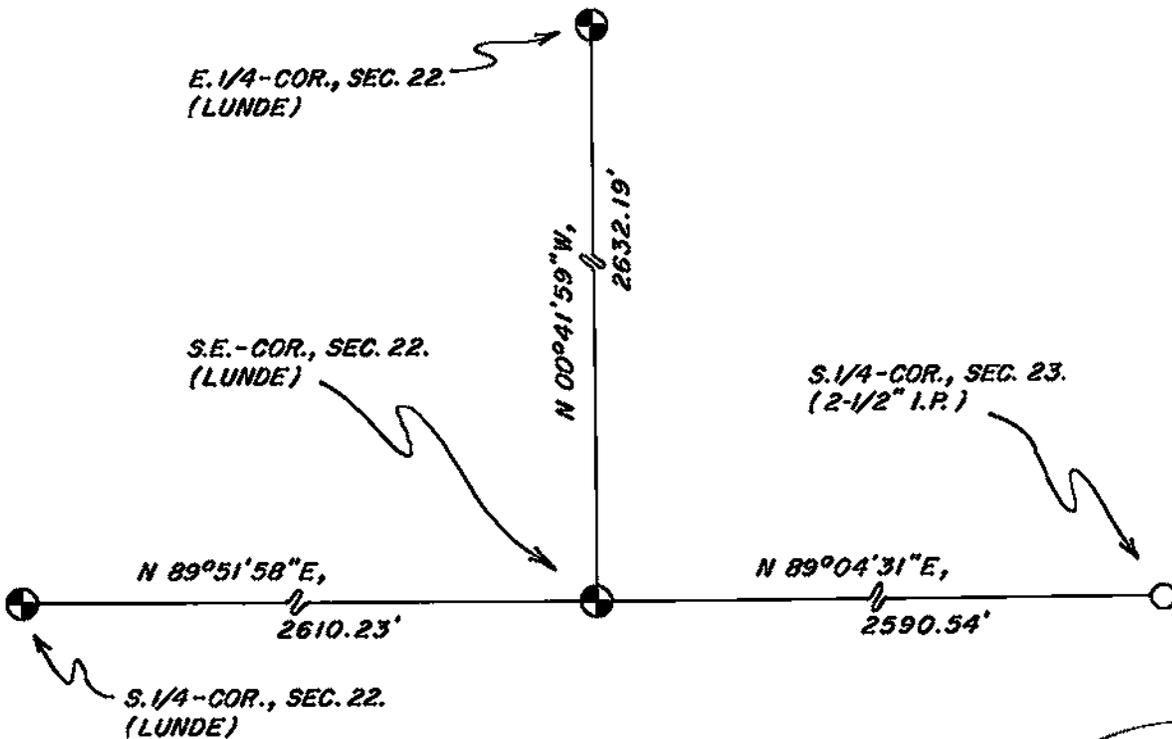

I, WILLIAM C. JUNG, COUNTY SURVEYOR
HEREBY CERTIFY THAT THE CORNER LOCATION SHOWN ON THIS RECORD
WAS DETERMINED BY ME OR UNDER MY DIRECTION AND CONTROL AND
THAT THIS U. S. PUBLIC LAND SURVEY MONUMENT RECORD IS CORRECT
AND COMPLETE TO THE BEST OF MY KNOWLEDGE AND BELIEF.

William C. Jung
Signature

11/12/97
Date



Seal