


21806222000

## U. S. PUBLIC LAND SURVEY MONUMENT RECORD

SECTION 22 T 18 N, R 6 W, TOWN OF FARMINGTON  
 LA CROSSE COUNTY

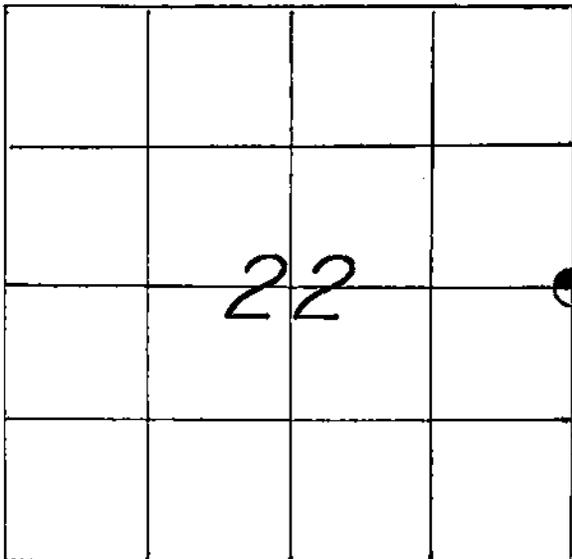

WISCONSIN COORDINATE SYSTEM

North

East

Theta Angle

Horiz. Order

Vert. Order

TYPE OF LANDMARK

*BRASS CAP LUNDE MARKER.*

BEARINGS ARE REFERENCED TO

*ASSUMED NORTH.*

LOCATION OF LANDMARK

CREW: WILLIAM C. JUNG  
 PETER F. FOLLANSBEE  
 DATE: 10/27/1997

Describe any record evidence, monument evidence, testimonial evidence or any other material evidence you considered and whether the monument was found or restored through acceptance of an obliterated evidence location.


I set this corner off of what I believe is the original government survey bearing tree to the Southeast. I set a Lunde at the corner.

Describe or show any material discrepancy between the location of the restored corner and that of the corner previously restored or reestablished.


*NONE KNOWN.*

RECORD OF DURABLE WITNESS MONUMENTS

NO	DESCRIPTION	BEARING	DISTANCE
1	SET A NAIL IN THE S-SIDE 14-1/2" ELM (SINGLE BLAZED)	WEST ±	21.11 FT.
2	SET A NAIL IN THE N-SIDE 5-1/2" ASPEN (DOUBLE BLAZED)	S 80°E (MAG.)	55.22 FT.
3	SET A NAIL IN THE N-SIDE 41" BURR OAK (UNBLAZED)	S 50°E (MAG.)	158.25 FT.
4	SET A NAIL IN THE N.W-SIDE 4 TRUNK ELM (DOUBLE BLAZED)	SOUTHERLY ±	29.16 FT.

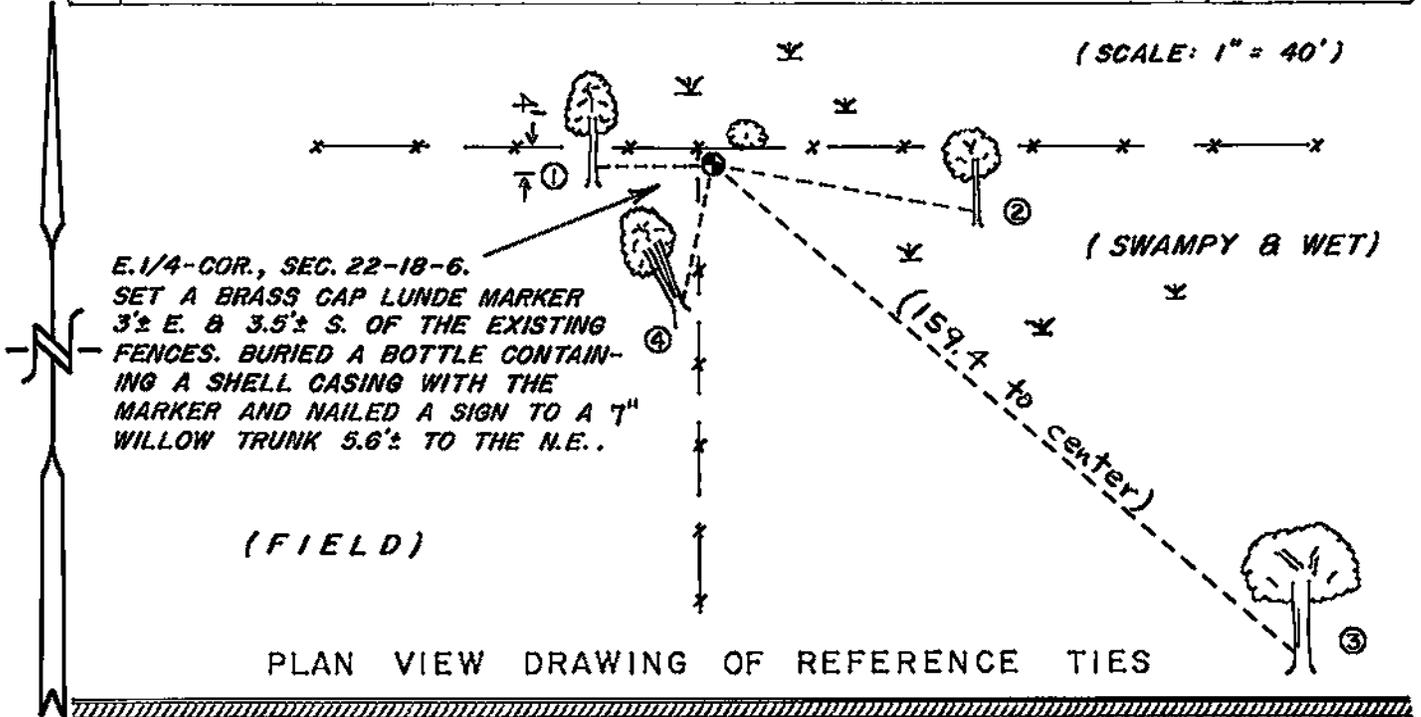

MAP SHOWING DISTANCE AND DIRECTION TO OTHER PUBLIC LAND SURVEY CORNERS USED FOR REESTABLISHING THE CORNER

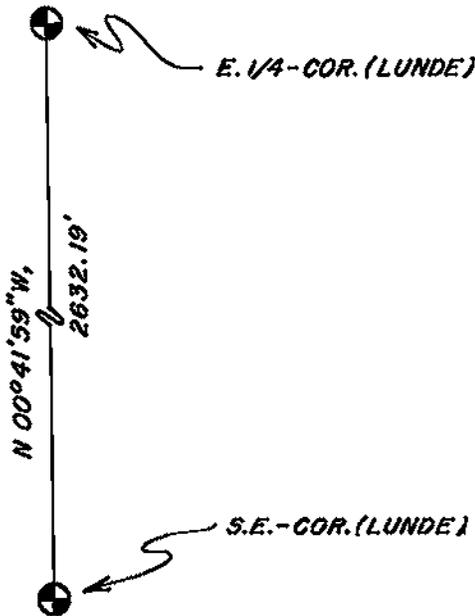

I, WILLIAM C. JUNG, COUNTY SURVEYOR  
 HEREBY CERTIFY THAT THE CORNER LOCATION SHOWN ON THIS RECORD  
 WAS DETERMINED BY ME OR UNDER MY DIRECTION AND CONTROL AND  
 THAT THIS U. S. PUBLIC LAND SURVEY MONUMENT RECORD IS CORRECT  
 AND COMPLETE TO THE BEST OF MY KNOWLEDGE AND BELIEF.

William C. Jung                      11/12/97  
 Signature                                      Date



Seal