


U. S. PUBLIC LAND SURVEY MONUMENT RECORD

SECTION 25 T 18 N, R 6 W, TOWN OF FARMINGTON

LA CROSSE COUNTY

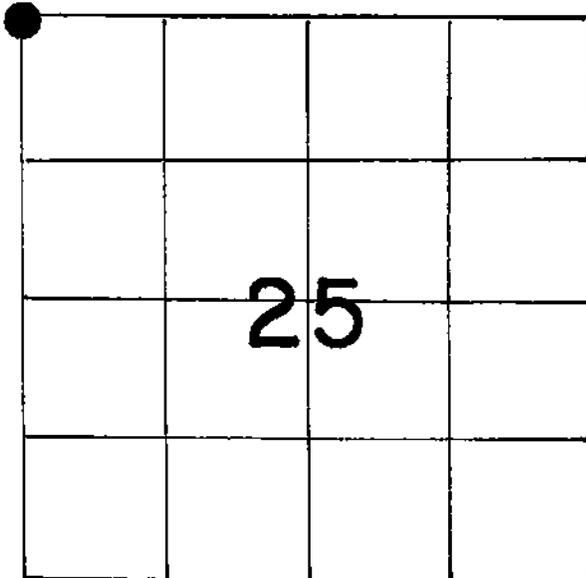

LOCATION OF LANDMARK

Crew: William Jung
 Perry Dahl
 5/29/85

WISCONSIN COORDINATE SYSTEM

North

East

Theta Angle

Horiz. Order

Vert. Order

 TYPE OF LANDMARK
 BERNTSEN

BEARINGS ARE REFERENCED TO

Describe any record evidence, monument evidence, testimonial evidence or any other material evidence you considered and whether the monument was found or restored through acceptance of an obliterated evidence location.


I set a Berntsen marker at Norm Hurlburt's computed location. I discussed this location with him and agreed with the method that he used to compute out the corner location. Scholze has since used this corner in a June, 1985 survey.

Describe or show any material discrepancy between the location of the restored corner and that of the corner previously restored or reestablished.

The highway maps show the corner to be in the road centerline. Hurlburt and I do not agree with this.

RECORD OF DURABLE WITNESS MONUMENTS

NO	DESCRIPTION	BEARING	DISTANCE
1	TELEPHONE BOX (center of)	-----	129'+
2	SET 1½" IRON PIPE (on line)	-----	38.36'
3	P.K. NAIL FOUND IN PLACE "	-----	29.11'
4	SET 1½" IRON PIPE "	-----	46.74'

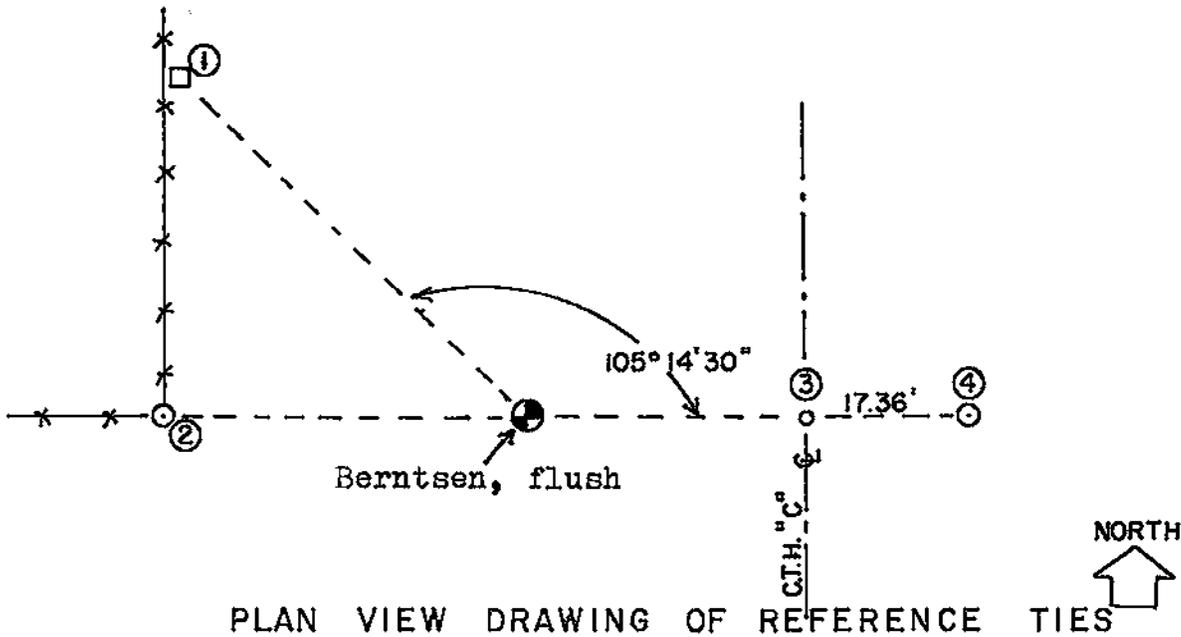

PLAN VIEW DRAWING OF REFERENCE TIES


MAP SHOWING DISTANCE AND DIRECTION TO OTHER PUBLIC LAND SURVEY CORNERS USED FOR REESTABLISHING THE CORNER

No measurements made by me at this time. See Hurlburt's map of record, dated June 10, 1985, in Sections 24 and 25.

I, William C. Jung, Deputy County Surveyor,
 HEREBY CERTIFY THAT THE CORNER LOCATION SHOWN ON THIS RECORD
 WAS DETERMINED BY ME OR UNDER MY DIRECTION AND CONTROL AND
 THAT THIS U. S. PUBLIC LAND SURVEY MONUMENT RECORD IS CORRECT
 AND COMPLETE TO THE BEST OF MY KNOWLEDGE AND BELIEF.

William C. Jung
 Signature

2/28/86
 Date

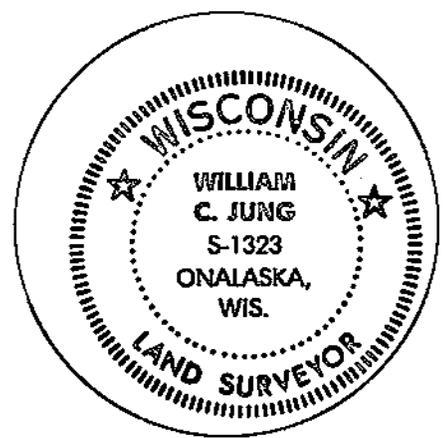

Seal