


U. S. PUBLIC LAND SURVEY MONUMENT RECORD

SECTION 23 T 18 N, R 6 W, TOWN OF FARMINGTON
LA CROSSE COUNTY

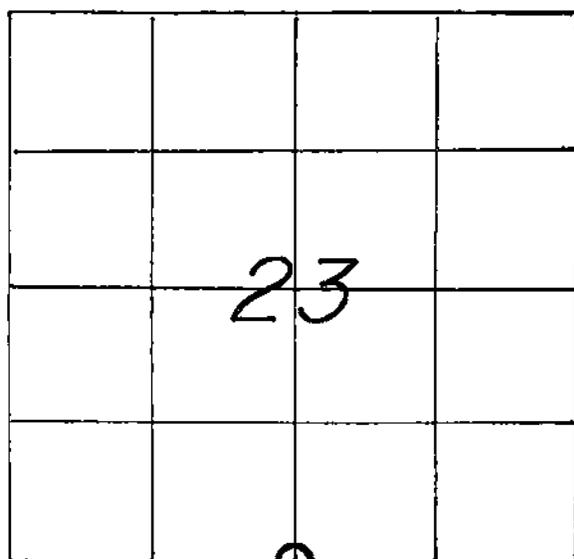

LOCATION OF LANDMARK

CREW: WILLIAM C. JUNG
PETER F. FOLLANSBEE
DATE: 10/27/1997

WISCONSIN COORDINATE SYSTEM

North

East

Theta Angle

Horiz. Order

Vert. Order

TYPE OF LANDMARK

2-1/2" x 36" IRON PIPE.

BEARINGS ARE REFERENCED TO

ASSUMED NORTH.

Describe any record evidence, monument evidence, testimonial evidence or any other material evidence you considered and whether the monument was found or restored through acceptance of an obliterated evidence location.


I accepted the old occupied corner as the best available evidence of the original government corner position and monumented the corner with an iron pipe.

Describe or show any material discrepancy between the location of the restored corner and that of the corner previously restored or reestablished.


NONE KNOWN.

RECORD OF DURABLE WITNESS MONUMENTS
MAGNETIC

NO	DESCRIPTION	BEARING	DISTANCE
1	SET A NAIL IN THE N.E.-SIDE 11" ELM (DOUBLE BLAZED)	N 25° W	24.49 FT.
2	SET A NAIL IN THE N.W.-SIDE 44" ELM (UNBLAZED)	N 75° E	20.81 FT.
3	SET A NAIL IN THE S.-SIDE 30" BOX ELDER (DBL. BLAZED)	N 84° E	47.02 FT.
4	SET A NAIL IN THE W.-SIDE 7" ELM (DOUBLE BLAZED)	S 02° W	38.00 FT.

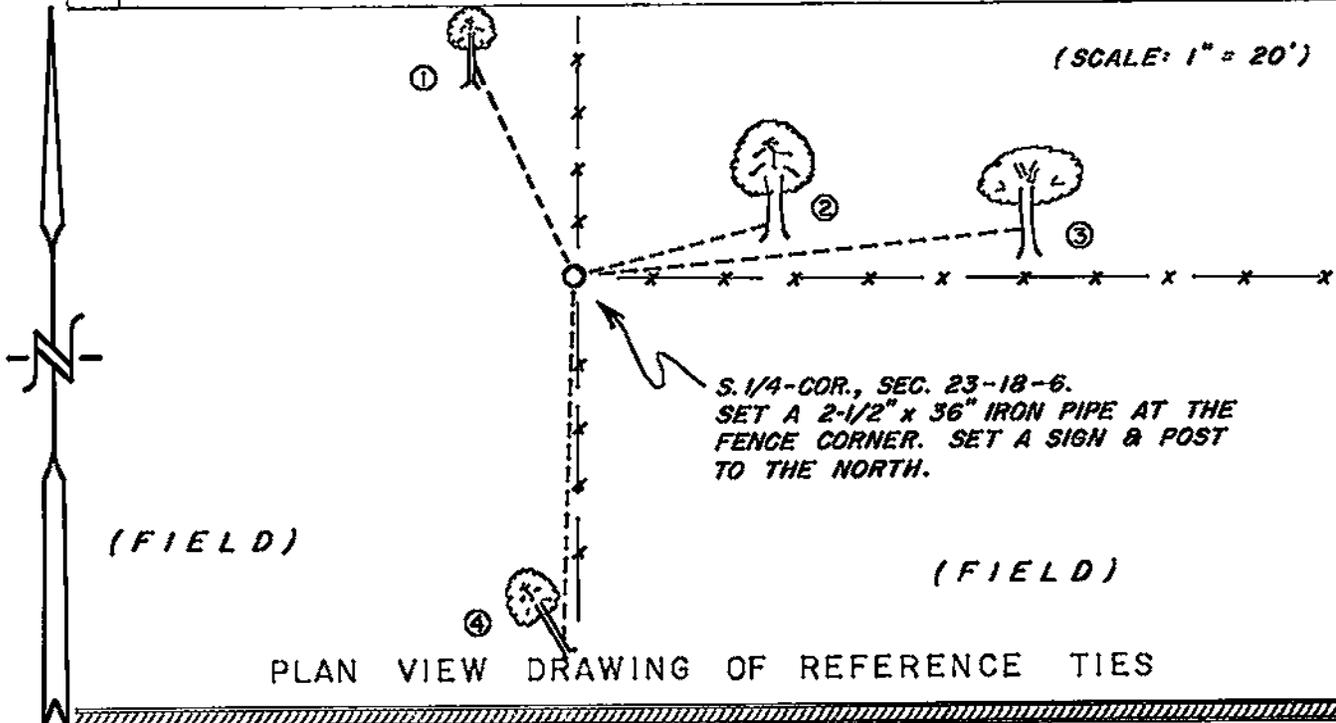

MAP SHOWING DISTANCE AND DIRECTION TO OTHER PUBLIC LAND SURVEY CORNERS USED FOR REESTABLISHING THE CORNER

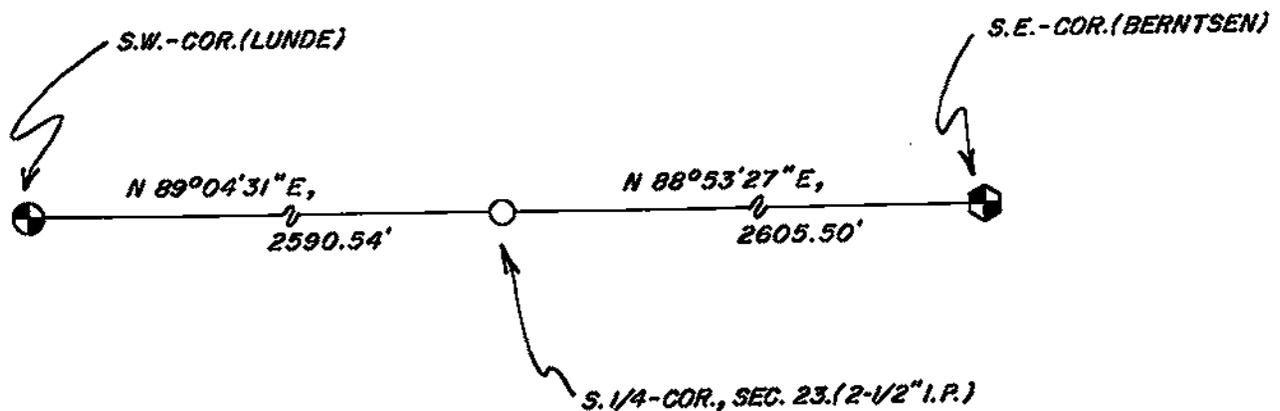

I, WILLIAM C. JUNG, COUNTY SURVEYOR
HEREBY CERTIFY THAT THE CORNER LOCATION SHOWN ON THIS RECORD WAS DETERMINED BY ME OR UNDER MY DIRECTION AND CONTROL AND THAT THIS U. S. PUBLIC LAND SURVEY MONUMENT RECORD IS CORRECT AND COMPLETE TO THE BEST OF MY KNOWLEDGE AND BELIEF.

William C. Jung 11/12/97
Signature Date

