


21806232000

## U. S. PUBLIC LAND SURVEY MONUMENT RECORD

SECTION 24 T 18 N, R 6 W, TOWN OF Farmington

LA CROSSE COUNTY

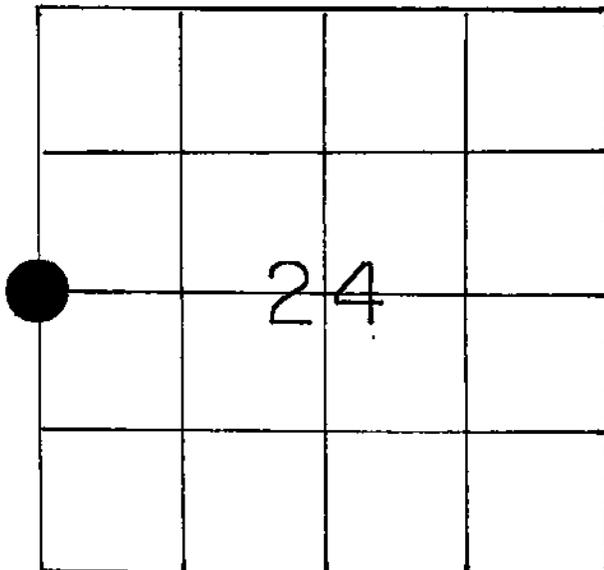

LOCATION OF LANDMARK

## WISCONSIN COORDINATE SYSTEM

North

East

Theta Angle

Horiz. Order

Vert. Order

## TYPE OF LANDMARK

SET BRASS CAP LUNDE MARKER

## BEARINGS ARE REFERENCED TO

Assumed

Crew: WILLIAM C. JUNG  
PETER F. FOLLANSBEE

Date: 11/18/ 1988

Describe any record evidence, monument evidence, testimonial evidence or any other material evidence you considered and whether the monument was found or restored through acceptance of an obliterated evidence location.


Norm Hurlburt and I accepted the old occupied fence corner as the best available evidence of the original government corner position. I set a brass capped Lunde marker 1' South of the fence post.

Describe or show any material discrepancy between the location of the restored corner and that of the corner previously restored or reestablished.


NONE KNOWN

RECORD OF DURABLE WITNESS MONUMENTS  
MAGNETIC

NO	DESCRIPTION	BEARING	DISTANCE
1	Set hexagon drill bit under fenceline	S 87° W	32.99 Ft.
2	Set P.K. Nail in E. side 21" Oak (Db. Bz)	N 03° W	114.65 Ft.
3	Buried German wine bottle under fence	N 01° W	21.15 Ft.
4			

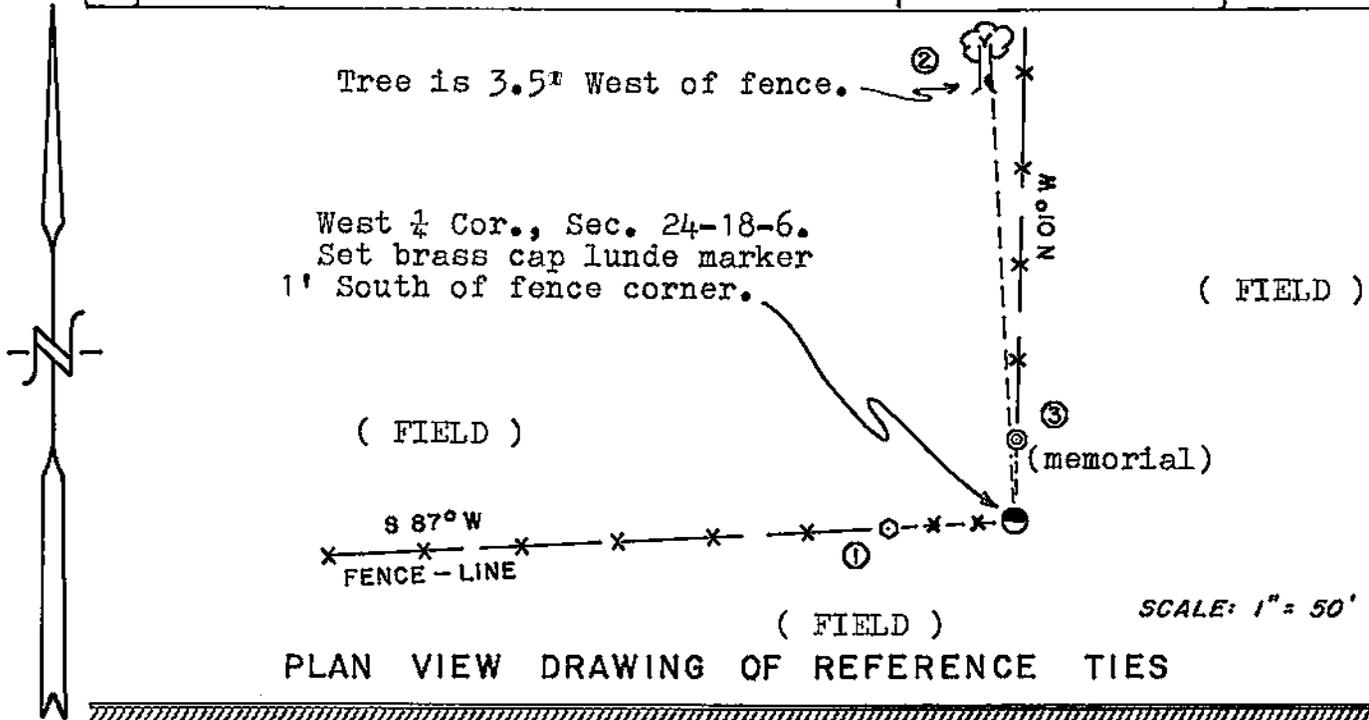

MAP SHOWING DISTANCE AND DIRECTION TO OTHER PUBLIC LAND SURVEY CORNERS USED FOR REESTABLISHING THE CORNER  
(not to scale)

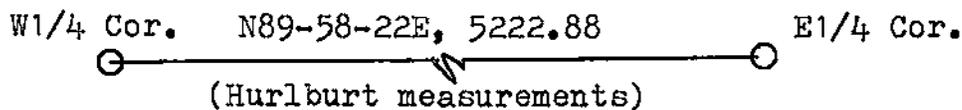

I, William C. Jung, Deputy County Surveyor  
HEREBY CERTIFY THAT THE CORNER LOCATION SHOWN ON THIS RECORD  
WAS DETERMINED BY ME OR UNDER MY DIRECTION AND CONTROL AND  
THAT THIS U. S. PUBLIC LAND SURVEY MONUMENT RECORD IS CORRECT  
AND COMPLETE TO THE BEST OF MY KNOWLEDGE AND BELIEF.

William C. Jung  
Signature

1/18/89  
Date



Seal