


U. S. PUBLIC LAND SURVEY MONUMENT RECORD

SECTION 25 T 18 N, R 6 W, TOWN OF FARMINGTON

LA CROSSE COUNTY

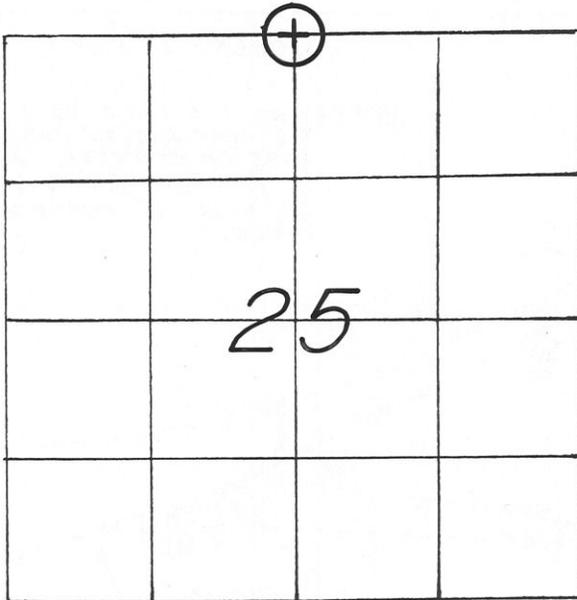

LOCATION OF LANDMARK

CREW: **BRYAN H. MEYER**
PETER F. FOLLANSBEE
 DATE: **5/04/2011**

WISCONSIN COORDINATE SYSTEM	
North	735,770.723
East	1,694,294.033
Theta Angle	
Horiz. Order	
Vert. Order	
DATUM:	1983('91)
TYPE OF LANDMARK	
3/4" x 30" IRON BAR WITH AN ALUMINUM CAP.	
BEARINGS ARE REFERENCED TO	

Describe any record evidence, monument evidence, testimonial evidence or any other material evidence you considered and whether the monument was found or restored through acceptance of an obliterated evidence location.

Describe or show any material discrepancy between the location of the restored corner and that of the corner previously restored or reestablished.


NONE KNOWN.

RECORD OF DURABLE WITNESS MONUMENTS

NO	DESCRIPTION	GRID BEARINGS	GROUND DIST.s
		BEARING	DISTANCE
1	SET A 3/4" x 24" REBAR WITH RED PLASTIC CAP	N 00°04'06"E	348.70 FT.
2	SET A 3/4" x 24" REBAR WITH RED PLASTIC CAP	N 59°49'09"E	371.06 FT.
3	SET A 10" SPIKE 33'± S.-EAST OF A POWER POLE	N 82°23'04"E	550.11 FT.
4	SET A 3/4" x 24" REBAR WITH RED PLASTIC CAP	N 86°27'45"E	615.43 FT.

SCALE: 1" = 150'

NOTE: NO. 1 IS 1' S.E. OF A R.R. TIE POST AND 20' FROM THE EDGE OF PAVEMENT, NO. 2 IS 11' FROM THE EDGE AND NO. 4 IS 1.5' NORTH OF A FENCE.

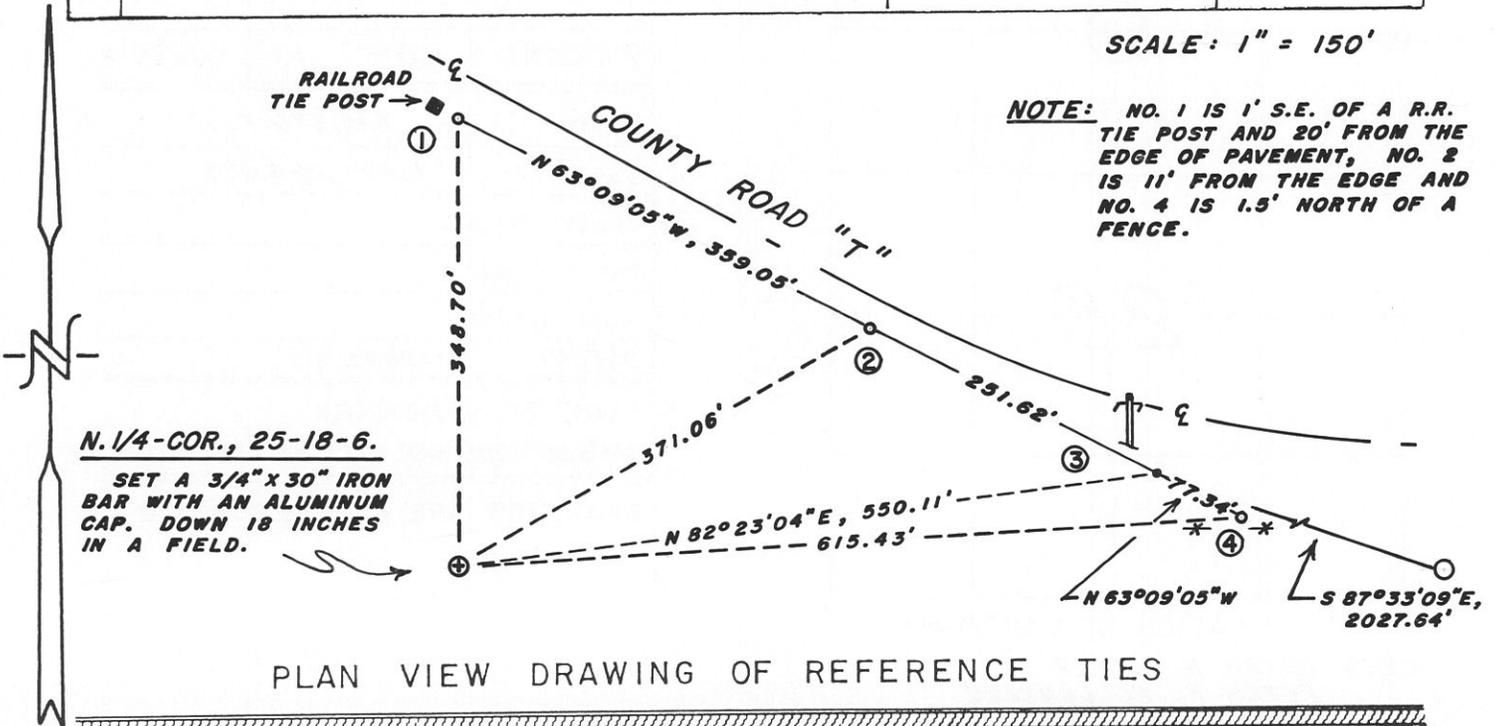

PLAN VIEW DRAWING OF REFERENCE TIES

MAP SHOWING DISTANCE AND DIRECTION TO OTHER PUBLIC LAND SURVEY CORNERS USED FOR REESTABLISHING THE CORNER

I, BRYAN H. MEYER, LA CROSSE COUNTY SURVEYOR
 HEREBY CERTIFY THAT THE CORNER LOCATION SHOWN ON THIS RECORD
 WAS DETERMINED BY ME OR UNDER MY DIRECTION AND CONTROL AND
 THAT THIS U. S. PUBLIC LAND SURVEY MONUMENT RECORD IS CORRECT
 AND COMPLETE TO THE BEST OF MY KNOWLEDGE AND BELIEF.

Bryan H. Meyer
 Signature

5/26/2011
 Date



Seal