


## U. S. PUBLIC LAND SURVEY MONUMENT RECORD

SECTION 24 T 18 N, R 6 W, TOWN OF Farmington

LA CROSSE COUNTY

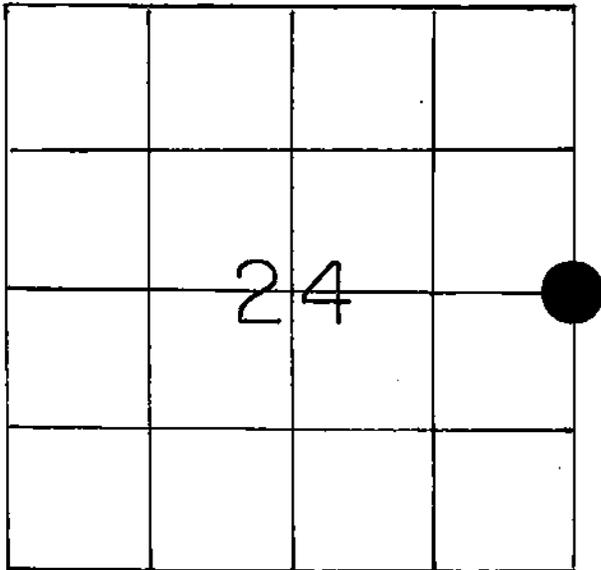

LOCATION OF LANDMARK

## WISCONSIN COORDINATE SYSTEM

North

East

Theta Angle

Horiz. Order

Vert. Order

## TYPE OF LANDMARK

BRASS CAP LUNDE MARKER

BEARINGS ARE REFERENCED TO

Assumed

Crew: WILLIAM C. JUNG  
PETER F. FOLLANSBEE

Date: 11/18/1988

Describe any record evidence, monument evidence, testimonial evidence or any other material evidence you considered and whether the monument was found or restored through acceptance of an obliterated evidence location.

Norm Hurlburt and I accepted the old occupied fence corner as the best available evidence of the original government corner position. I set a brass capped Lunde marker by the old downed fence corner. While digging, I dug up an old corner post. The corner is mounded with rocks, and a German wine bottle is buried to the South of the Lunde.

Describe or show any material discrepancy between the location of the restored corner and that of the corner previously restored or reestablished.

NONE KNOWN

