


U. S. PUBLIC LAND SURVEY MONUMENT RECORD

SECTION 25 T 18 N, R 6 W, TOWN OF FARMINGTON
 LA CROSSE COUNTY

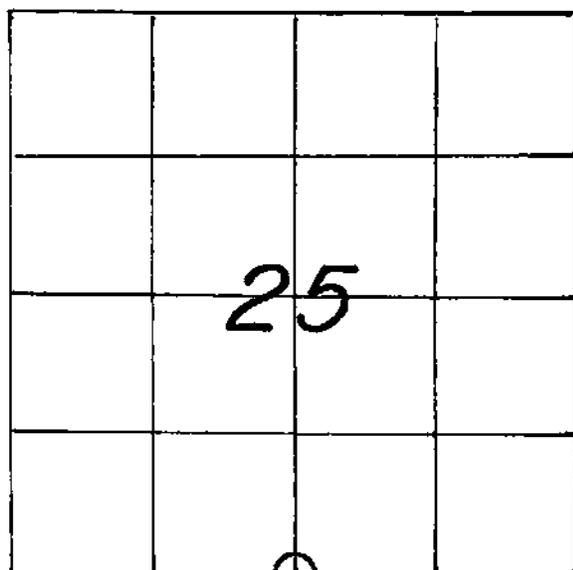

LOCATION OF LANDMARK

WISCONSIN COORDINATE SYSTEM
North
East
Theta Angle
Horiz. Order
Vert. Order
TYPE OF LANDMARK
1" x 29" Iron Pipe.
BEARINGS ARE REFERENCED TO

Crew: WILLIAM C. JUNG
 PETER F. FOLLANSBEE
 Date: 2/02/95 & 8/08/95

Describe any record evidence, monument evidence, testimonial evidence or any other material evidence you considered and whether the monument was found or restored through acceptance of an obliterated evidence location.

I found a nail at the occupied corner which I believe was set by Hofmeister in 1979. Fairchild traversed to this point and verified that it fits Hofmeister's section split of Section 25. I replaced the nail with an iron pipe set in the tree roots. I accepted this location as the best available evidence of the original government corner position.

Describe or show any material discrepancy between the location of the restored corner and that of the corner previously restored or reestablished.

None Known.

