


U. S. PUBLIC LAND SURVEY MONUMENT RECORD

SECTION 25 T 18 N, R 6 W, TOWN OF FARMINGTON

LA CROSSE COUNTY

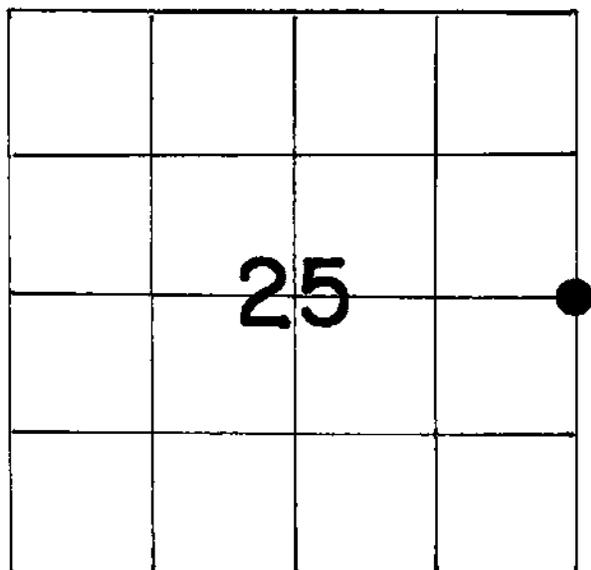

LOCATION OF LANDMARK

Crew: William Jung
Perry Dahl

5/29/85

WISCONSIN COORDINATE SYSTEM

North

East

Theta Angle

Horiz. Order

Vert. Order

TYPE OF LANDMARK
BERNTSEN

BEARINGS ARE REFERENCED TO

Describe any record evidence, monument evidence, testimonial evidence or any other material evidence you considered and whether the monument was found or restored through acceptance of an obliterated evidence location.

Hofmeister set a 3/4" iron pipe at this corner in June of 1979. In May of 1980 he used this corner for surveys in Sections 25, and 30 to the East. Norm Hurlburt used this corner in May of 1985. I removed the pipe and replaced it with a Berntsen marker. I accepted this location as the best possible evidence of the original government corner location.


Describe or show any material discrepancy between the location of the restored corner and that of the corner previously restored or reestablished.

None known.

RECORD OF DURABLE WITNESS MONUMENTS
MAGNETIC

NO	DESCRIPTION	BEARING	DISTANCE
1	9" DOUBLE-BLAZED ASPEN	S83°W	5.27'
2	14" DOUBLE-BLAZED BURR OAK	S25°E	21.85'
3	9" DOUBLE-BLAZED BURR OAK	S47°E	15.38'
4	DOUBLE-BLAZED BURR OAK	S73°E	21.46'

(All distances are to P.K.'s in hacks.)

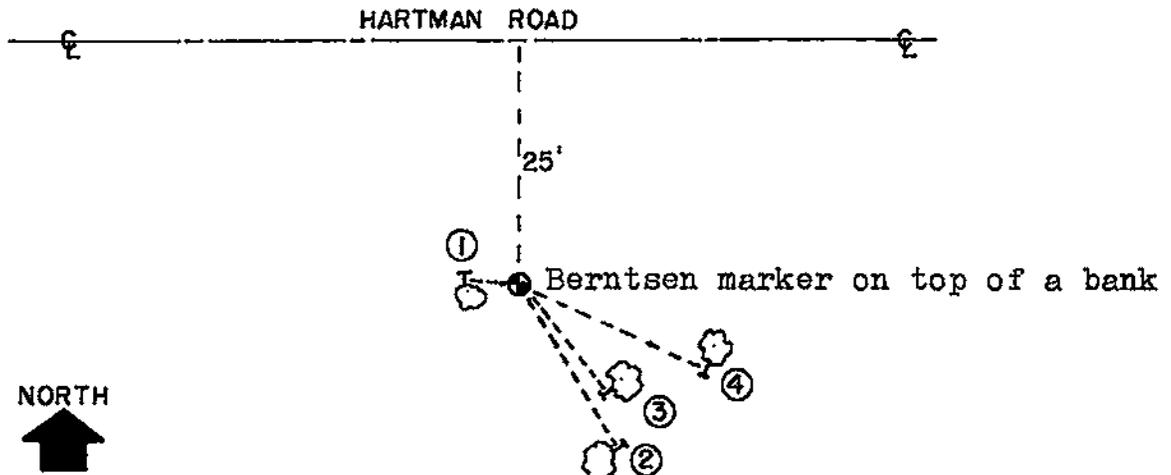

PLAN VIEW DRAWING OF REFERENCE TIES


MAP SHOWING DISTANCE AND DIRECTION TO OTHER PUBLIC LAND SURVEY CORNERS USED FOR REESTABLISHING THE CORNER

No measurements made by me at this time. See maps of record.

I, William C. Jung, Deputy County Surveyor,
HEREBY CERTIFY THAT THE CORNER LOCATION SHOWN ON THIS RECORD
WAS DETERMINED BY ME OR UNDER MY DIRECTION AND CONTROL AND
THAT THIS U. S. PUBLIC LAND SURVEY MONUMENT RECORD IS CORRECT
AND COMPLETE TO THE BEST OF MY KNOWLEDGE AND BELIEF.

William C. Jung
Signature

2/28/86
Date

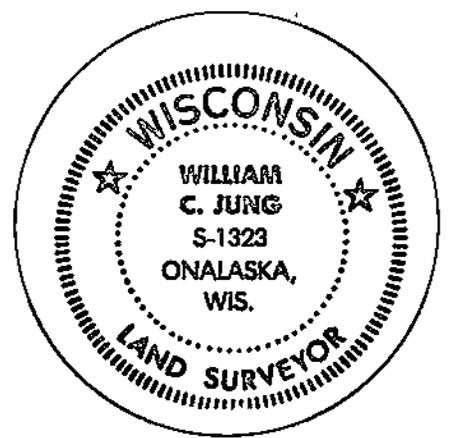

Seal