


21806262000

U. S. PUBLIC LAND SURVEY MONUMENT RECORD

SECTION 25 T 18 N, R 6 W, TOWN OF Farmington

LA CROSSE COUNTY

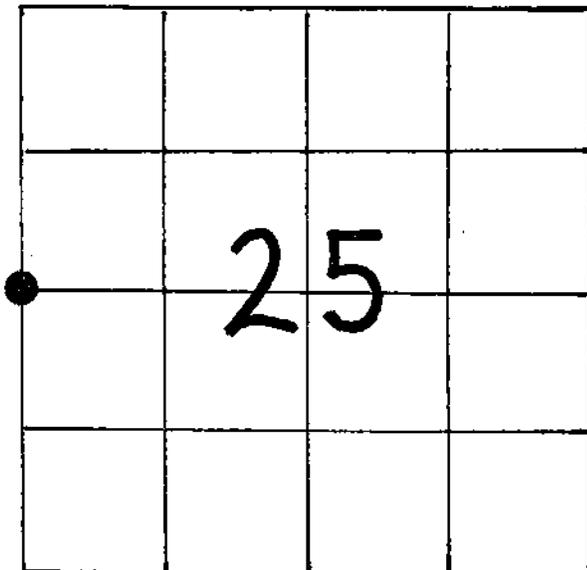

LOCATION OF LANDMARK

Crew: William C. Jung
Peter F. Follansbee

Date: April 10, 1991

Describe any record evidence, monument evidence, testimonial evidence or any other material evidence you considered and whether the monument was found or restored through acceptance of an obliterated evidence location.

I found a field rock with a "chiselled cross" at the occupied fence corner. This point had been used as the corner in previous survey work done by Hofmeister and Norm Hurlburt. I accepted this point at the occupied fence corner as the best available evidence of the original government corner position. I removed the stone and replaced it with a Berntsen top in a 1⁵/₈"x35" iron pipe. I also set a sign and post to the Northeast, buried a wine bottle with a shell casing near the pipe, and set the old stone to the Northwest of the corner. The Berntsen is West of the fence corner. The ground was very wet.

Describe or show any material discrepancy between the location of the restored corner and that of the corner previously restored or reestablished.

None known.

WISCONSIN COORDINATE SYSTEM

North

East

Theta Angle

Horiz. Order

Vert. Order

TYPE OF LANDMARK


Berntsen top in an iron pipe

BEARINGS ARE REFERENCED TO

Assumed

RECORD OF DURABLE WITNESS MONUMENTS


NO	DESCRIPTION	BEARING	DISTANCE
1	To the center of a burr oak, c=9.7'	N2°W	638.5'
2	Set a 5/8" x 4'± rebar	West ±	18.98'
3	"	South ±	27.29'
4	"	East ±	44.21'

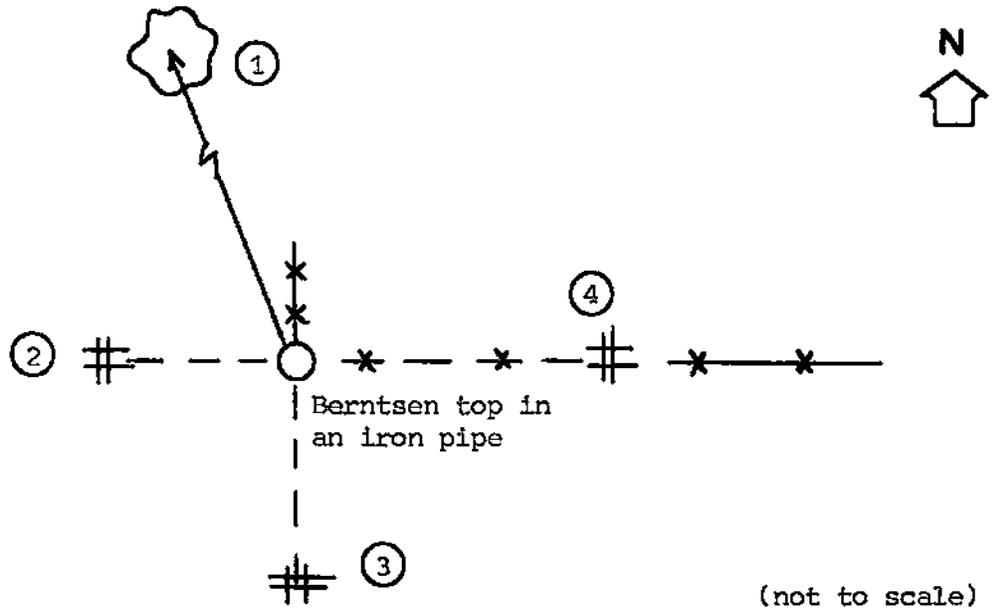

PLAN VIEW DRAWING OF REFERENCE TIES


MAP SHOWING DISTANCE AND DIRECTION TO OTHER PUBLIC LAND SURVEY CORNERS USED FOR REESTABLISHING THE CORNER

(not to scale)

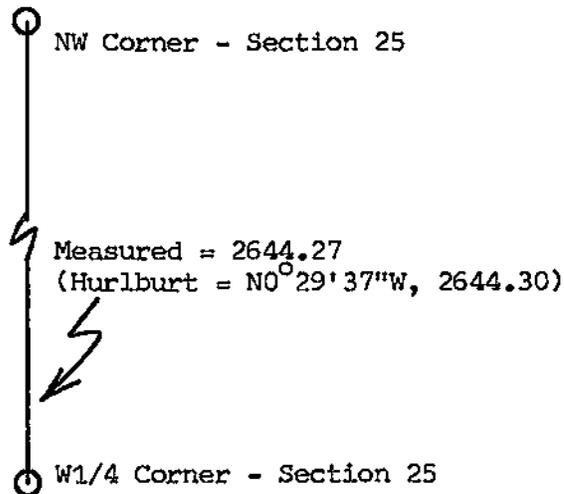

I, William C. Jung, Deputy County Surveyor,
 HEREBY CERTIFY THAT THE CORNER LOCATION SHOWN ON THIS RECORD
 WAS DETERMINED BY ME OR UNDER MY DIRECTION AND CONTROL AND
 THAT THIS U. S. PUBLIC LAND SURVEY MONUMENT RECORD IS CORRECT
 AND COMPLETE TO THE BEST OF MY KNOWLEDGE AND BELIEF.

William C. Jung April 19, 1991
 Signature Date

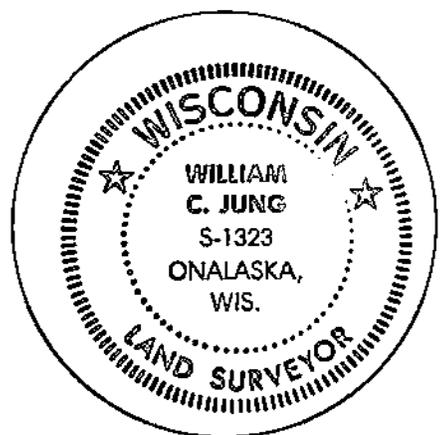

Seal