


21806270000

U. S. PUBLIC LAND SURVEY MONUMENT RECORD

SECTION 35 T 18 N, R 6 W, TOWN OF FARMINGTON

LA CROSSE COUNTY

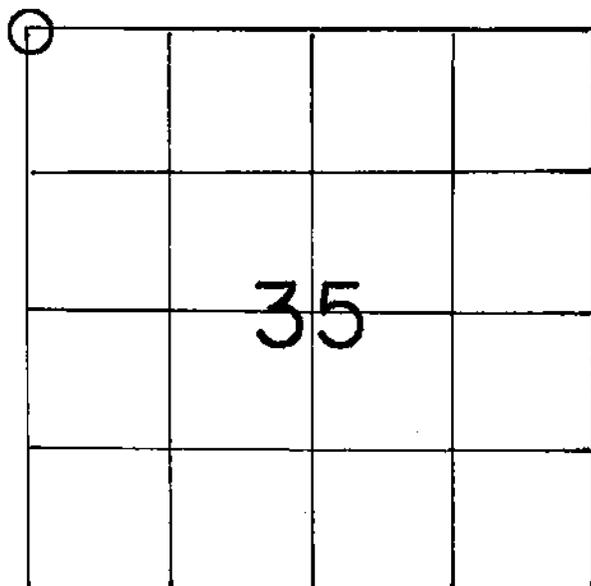

LOCATION OF LANDMARK

Crew: WILLIAM C. JUNG
 PETER F. FOLLANSBEE
 Date: 12/16/1994

Describe any record evidence, monument evidence, testimonial evidence or any other material evidence you considered and whether the monument was found or restored through acceptance of an obliterated evidence location.

I accepted the old occupied fence corner as the best available evidence of the original government corner position and monumented it with an iron pipe. Dick Berg had also measured to this corner when surveying West in Section 34.


Describe or show any material discrepancy between the location of the restored corner and that of the corner previously restored or reestablished.

None Known.


WISCONSIN COORDINATE SYSTEM	
North	730,562.014
East	1,686,399.726
Theta Angle	
Horiz. Order	
Vert. Order	
DATUM:	1983('91)
TYPE OF LANDMARK	
Set 2 ¹ / ₄ " x 30" Iron Pipe.	
BEARINGS ARE REFERENCED TO	
True North.	

RECORD OF DURABLE WITNESS MONUMENTS

NO	DESCRIPTION	MAGNETIC	
		BEARING	DISTANCE
1	Set P.K. Nail in SW-side 4" Oak	Northwesterly ±	10.33 Ft.
2	Set P.K. Nail in NW-side 7" Oak	Northeasterly ±	24.02 Ft.
3	Set P.K. Nail in E.-side 5" Hickory	S 22° W	19.39 Ft.
4	Set P.K. Nail in NW-side 14" Oak	S 70° W	17.33 Ft.

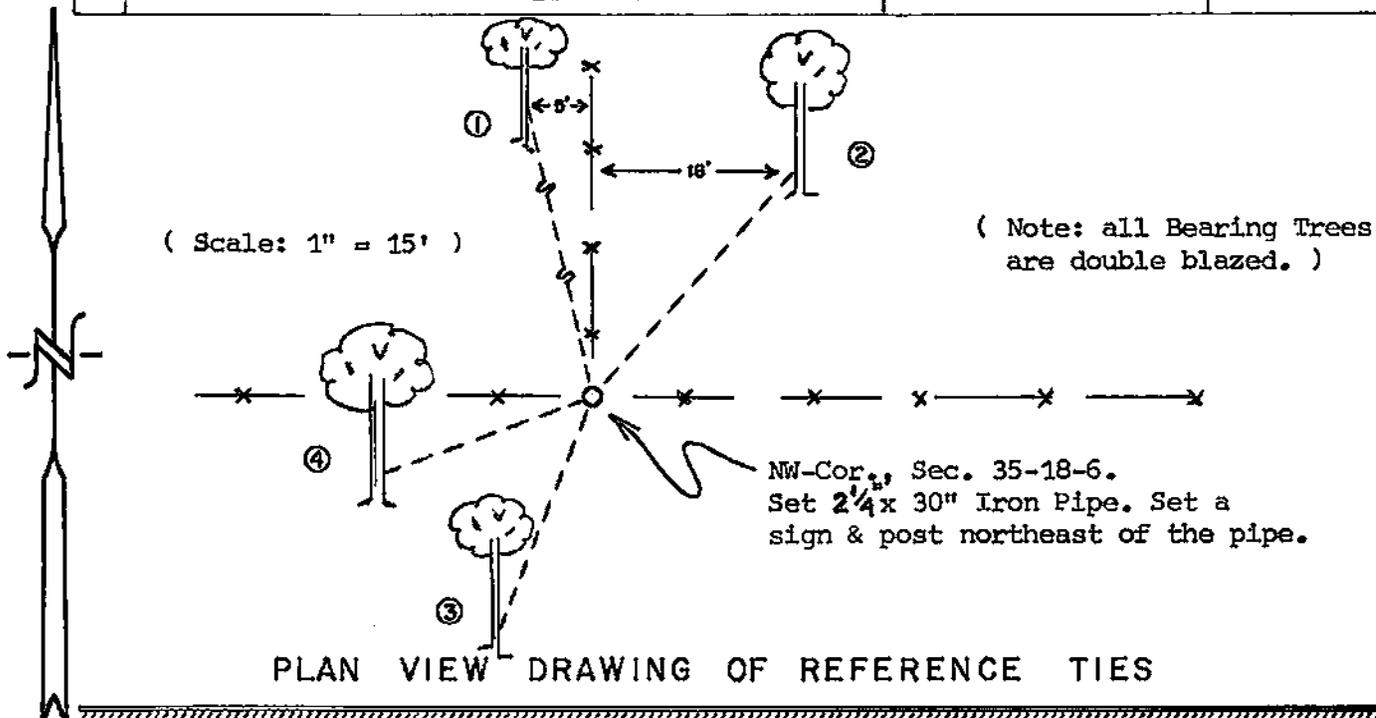


MAP SHOWING DISTANCE AND DIRECTION TO OTHER PUBLIC LAND SURVEY CORNERS USED FOR REESTABLISHING THE CORNER (not to scale)

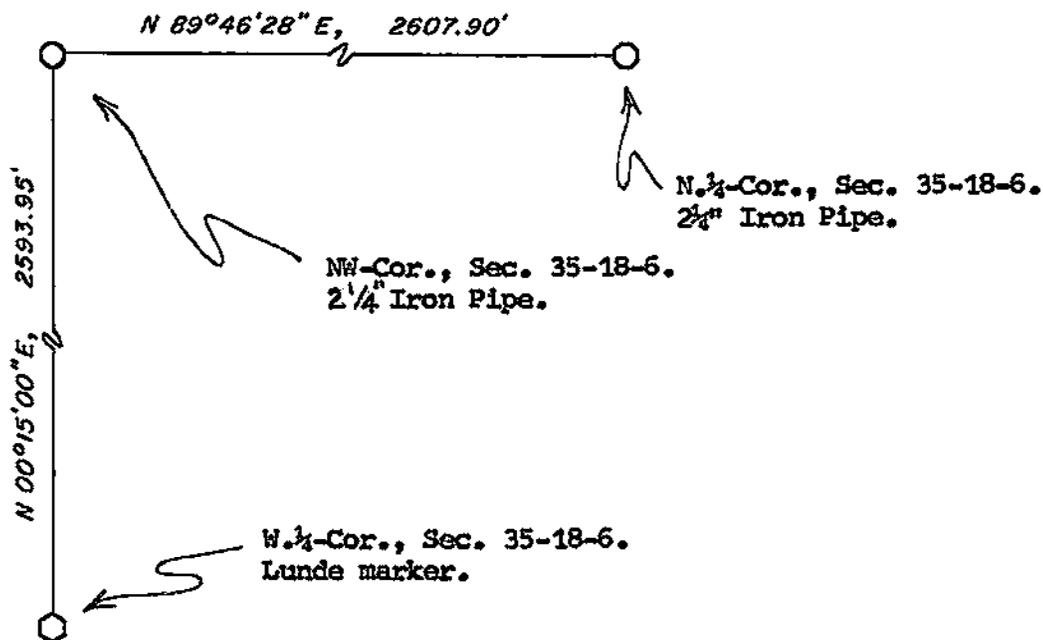

I, William C. Jung, County Surveyor
HEREBY CERTIFY THAT THE CORNER LOCATION SHOWN ON THIS RECORD WAS DETERMINED BY ME OR UNDER MY DIRECTION AND CONTROL AND THAT THIS U. S. PUBLIC LAND SURVEY MONUMENT RECORD IS CORRECT AND COMPLETE TO THE BEST OF MY KNOWLEDGE AND BELIEF.


William C. Jung
Signature

2/10/95
Date


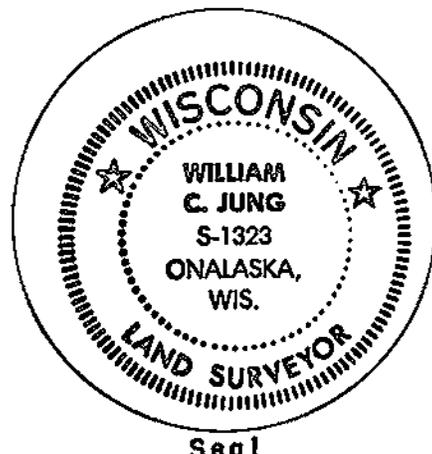


Seal

COUNTY ROAD "C"

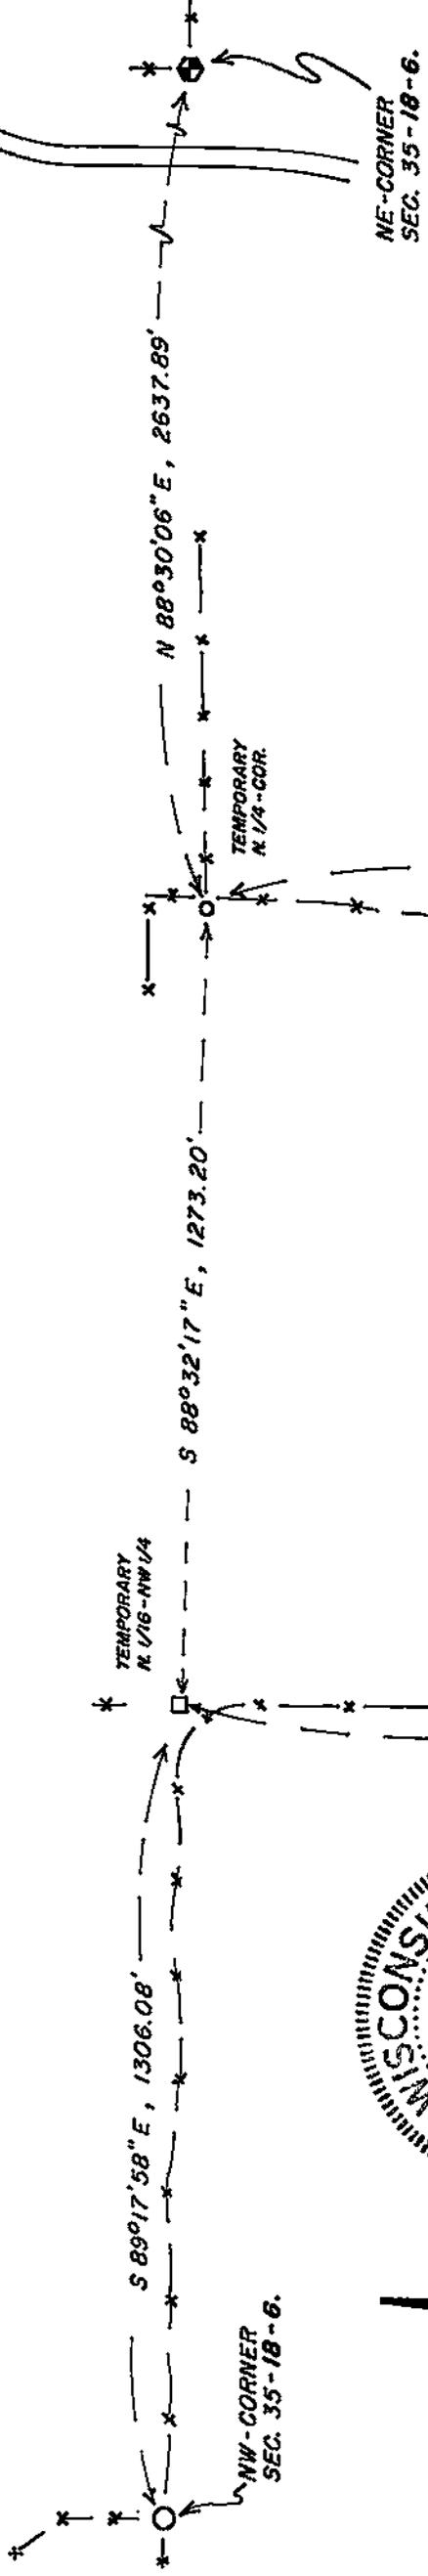

L E G E N D	
○	2 1/4" IRON PIPE
□	HUB & TACK
○	IRON BAR
•	NAIL
○	1" IRON PIPE
●	LUNDE MARKER

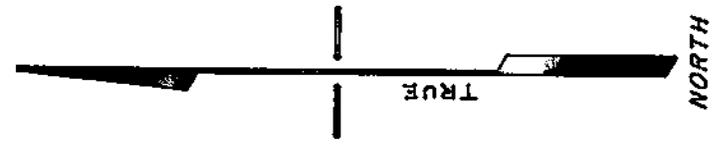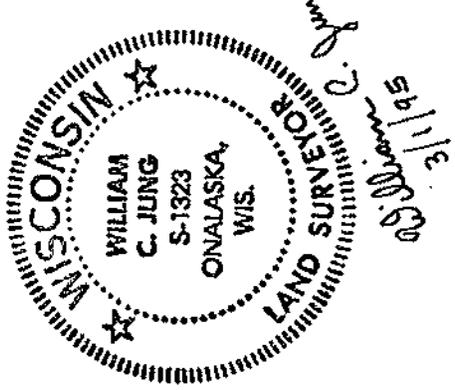

WET COULEE CEMETERY

SCALE: 1" = 300'

W. C. JUNG - COUNTY SURVEYOR
DRAFTED BY: R.F.F., LA CROSSE COUNTY SURVEYORS DEPT