


21806272000

U. S. PUBLIC LAND SURVEY MONUMENT RECORD

SECTION 26 T 18 N, R 6 W, TOWN OF FARMINGTON

LA CROSSE COUNTY

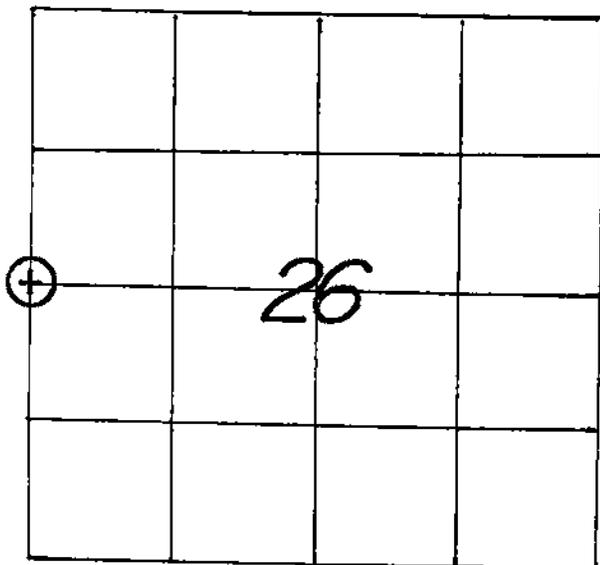

WISCONSIN COORDINATE SYSTEM	
North	733,159.836
East	1,686,432.367
Theta Angle	
Horiz. Order	
Vert. Order	
DATUM:	1983('91)
TYPE OF LANDMARK	
3/4" x 30" IRON BAR WITH AN ALUMINUM CAP.	
BEARINGS ARE REFERENCED TO	
GRID NORTH AS PER SECTION DATA.	

LOCATION OF LANDMARK

CREW: WILLIAM C. JUNG
 PETER F. FOLLANSBEE
 DATE: 12/22/2005

Describe any record evidence, monument evidence, testimonial evidence or any other material evidence you considered and whether the monument was found or restored through acceptance of an obliterated evidence location.

We set an iron bar and cap at the location of an old downed and rotted fence post. After analyzing this location and the section measurements to the North and South and comparing this evidence against the previous work that we had done in the surrounding sections, I accepted the old fence corner location as the best available evidence of the original government corner position.

Describe or show any material discrepancy between the location of the restored corner and that of the corner previously restored or reestablished.

NONE KNOWN.

