


U. S. PUBLIC LAND SURVEY MONUMENT RECORD

SECTION 28 T 18 N, R 6 W, TOWN OF FARMINGTON  
 LA CROSSE COUNTY

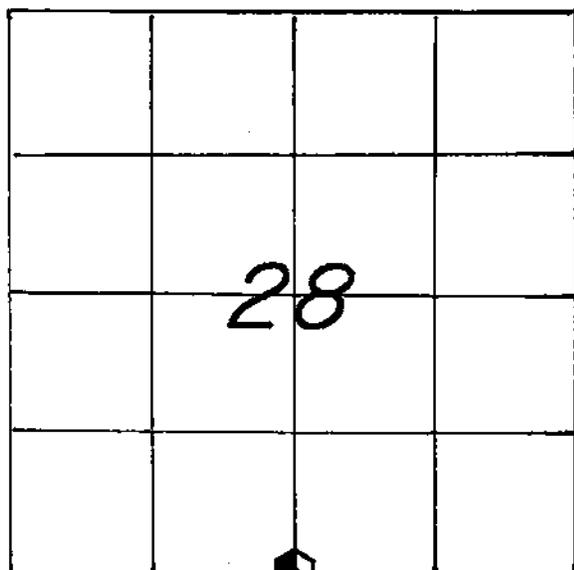

LOCATION OF LANDMARK

WISCONSIN COORDINATE SYSTEM
North
East
Theta Angle
Horiz. Order
Vert. Order
TYPE OF LANDMARK
Brass cap Lunde marker.
BEARINGS ARE REFERENCED TO

Crew: WILLIAM C. JUNG  
 PETER F. FOLLANSBEE  
 Date: 5/11/1995

Describe any record evidence, monument evidence, testimonial evidence or any other material evidence you considered and whether the monument was found or restored through acceptance of an obliterated evidence location.


I found an iron pipe at the occupied corner, removed it, and replaced it with a brass capped Lunde marker. I accepted the occupied corner as the best available evidence of the original government corner position. The occupied corner had been used as the corner in previous survey work. It appears that the distance East to the section corner fits the original notes very well.

Describe or show any material discrepancy between the location of the restored corner and that of the corner previously restored or reestablished.

NONE KNOWN.

RECORD OF DURABLE WITNESS MONUMENTS

NO	DESCRIPTION	BEARING	DISTANCE
1	Set P.K. Nail in NE-side 22" White Oak	N 75° W = Mag.	33.69 Ft.
2	Set P.K. Nail in SW-side 13" White Oak	North ±	27.72 Ft.
3	Set P.K. Nail in SW-side 10" White Oak	Southeasterly±	38.83 Ft.
4	Set P.K. Nail in NE-side 12" White Oak	Southeasterly±	39.32 Ft.

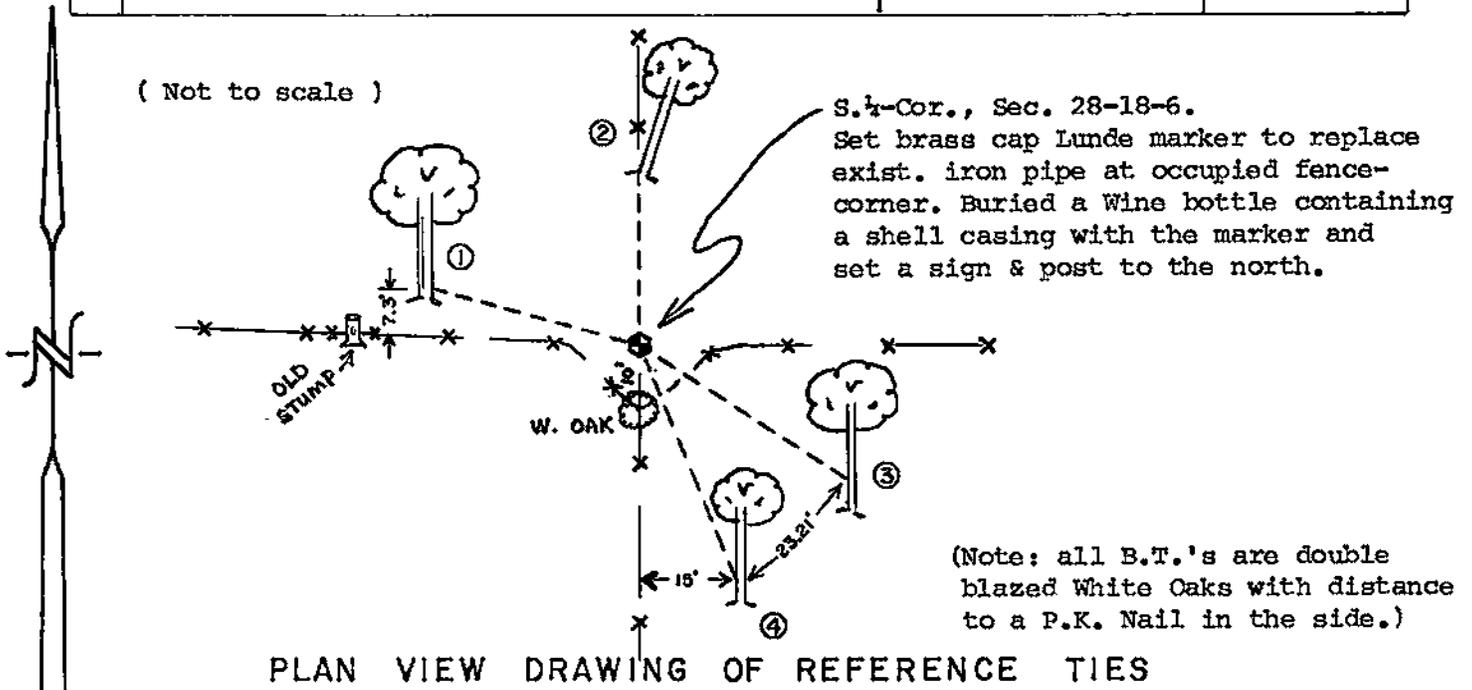


MAP SHOWING DISTANCE AND DIRECTION TO OTHER PUBLIC LAND SURVEY CORNERS USED FOR REESTABLISHING THE CORNER

No section measurements were made by me at this time.

I, William C. Jung, County Surveyor  
HEREBY CERTIFY THAT THE CORNER LOCATION SHOWN ON THIS RECORD WAS DETERMINED BY ME OR UNDER MY DIRECTION AND CONTROL AND THAT THIS U. S. PUBLIC LAND SURVEY MONUMENT RECORD IS CORRECT AND COMPLETE TO THE BEST OF MY KNOWLEDGE AND BELIEF.

William C. Jung 12/14/95  
Signature Date

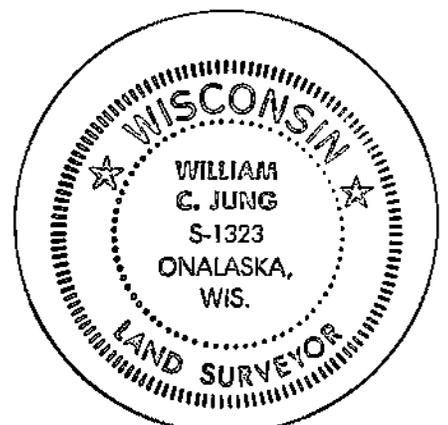

Seal