


21806290000

U. S. PUBLIC LAND SURVEY MONUMENT RECORD

SECTION 28 T 18 N, R 6 W, TOWN OF FARMINGTON
 LA CROSSE COUNTY

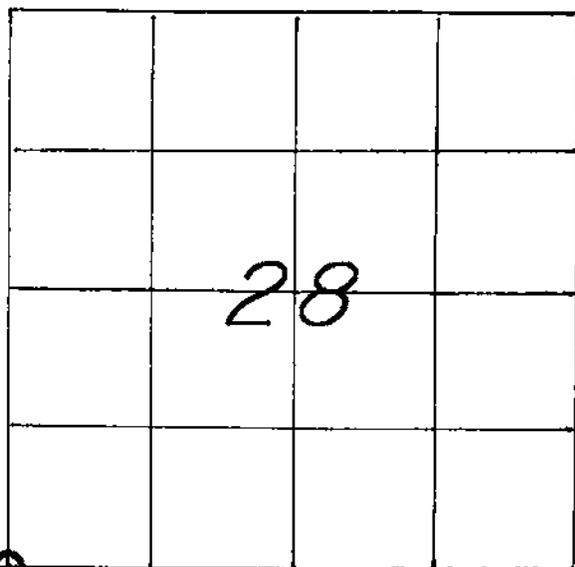

LOCATION OF LANDMARK

CREW: WILLIAM C. JUNG
 PETER F. FOLLANSBEE
 DATE: 10/10/1997

WISCONSIN COORDINATE SYSTEM

North

East

Theta Angle

Horiz. Order

Vert. Order

TYPE OF LANDMARK

3/4" x 30" ROUND IRON BAR W/ALUM. CAP.

BEARINGS ARE REFERENCED TO

ASSUMED NORTH.

Describe any record evidence, monument evidence, testimonial evidence or any other material evidence you considered and whether the monument was found or restored through acceptance of an obliterated evidence location.

We found an iron pipe at the old occupied corner. This pipe had been used as the corner in previous work. This location fit our section computations and measurements very well. Therefore I accepted this location as the best available evidence of the original government corner location. I set an iron bar with cap inside of the existing pipe.

Describe or show any material discrepancy between the location of the restored corner and that of the corner previously restored or reestablished.

NONE KNOWN.

