


U. S. PUBLIC LAND SURVEY MONUMENT RECORD

SECTION 29 T 18 N, R 6 W, TOWN OF FARMINGTON

LA CROSSE COUNTY

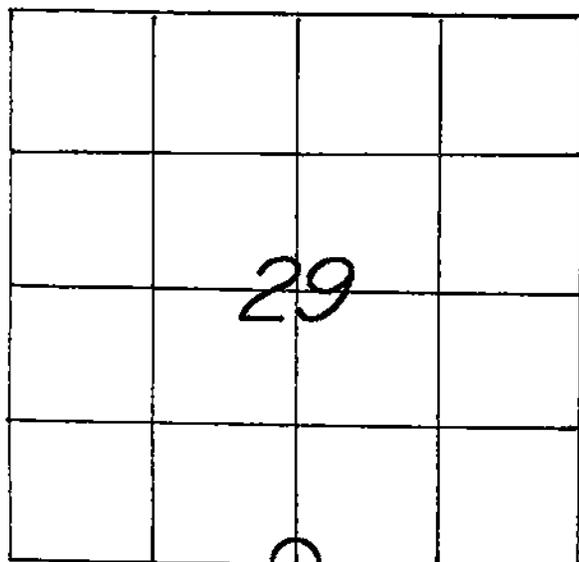

LOCATION OF LANDMARK

CREW: WILLIAM C. JUNG
 PETER F. FOLLANSBEE
 DATE: 2/18/2004

WISCONSIN COORDINATE SYSTEM

North

East

Theta Angle

Horiz. Order

Vert. Order

TYPE OF LANDMARK

1/4" (O.D.) IRON PIPE.

BEARINGS ARE REFERENCED TO

Describe any record evidence, monument evidence, testimonial evidence or any other material evidence you considered and whether the monument was found or restored through acceptance of an obliterated evidence location.


I found an iron pipe at the occupied location (projections of fences). This pipe had been used as the 1/4 corner in previous surveys. I accepted this pipe as the best available evidence of the original government corner position.

Describe or show any material discrepancy between the location of the restored corner and that of the corner previously restored or reestablished.

NONE KNOWN.

RECORD OF DURABLE WITNESS MONUMENTS

NO	DESCRIPTION	MAGNETIC	
		BEARING	DISTANCE
1	SET A NAIL IN N.W.-SIDE OF AN 11" HICKORY	N 35° E	SLOPE=28.60'
2	SET A NAIL IN S.-SIDE OF A 25" ASH	N 88° E	47.22 FT.
3	SET A NAIL IN S.W.-SIDE OF A 4" HICKORY	S 34° E	8.26 FT.
4	SET A NAIL IN S.E.-SIDE OF A 5" HICKORY	S 80° W	33.14 FT.

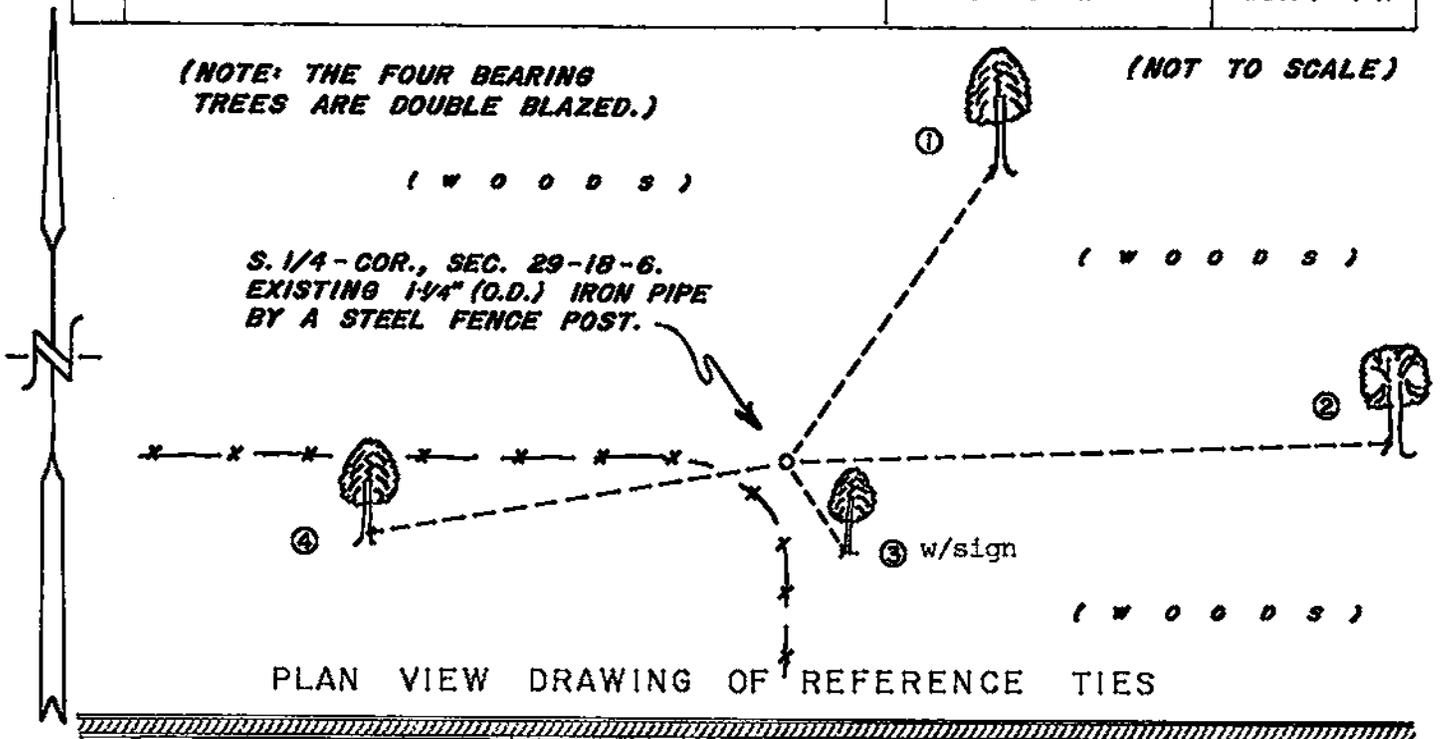

MAP SHOWING DISTANCE AND DIRECTION TO OTHER PUBLIC LAND SURVEY CORNERS USED FOR REESTABLISHING THE CORNER

I made no further section measurements. Previous survey work confirmed the location of this corner.

I, WILLIAM C. JUNG, COUNTY SURVEYOR
HEREBY CERTIFY THAT THE CORNER LOCATION SHOWN ON THIS RECORD WAS DETERMINED BY ME OR UNDER MY DIRECTION AND CONTROL AND THAT THIS U. S. PUBLIC LAND SURVEY MONUMENT RECORD IS CORRECT AND COMPLETE TO THE BEST OF MY KNOWLEDGE AND BELIEF.

William C. Jung 2/17/05
Signature Date



Seal