


## U. S. PUBLIC LAND SURVEY MONUMENT RECORD

SECTION 30 T 18 N, R 6 W, TOWN OF FARMINGTON  
LA CROSSE COUNTY

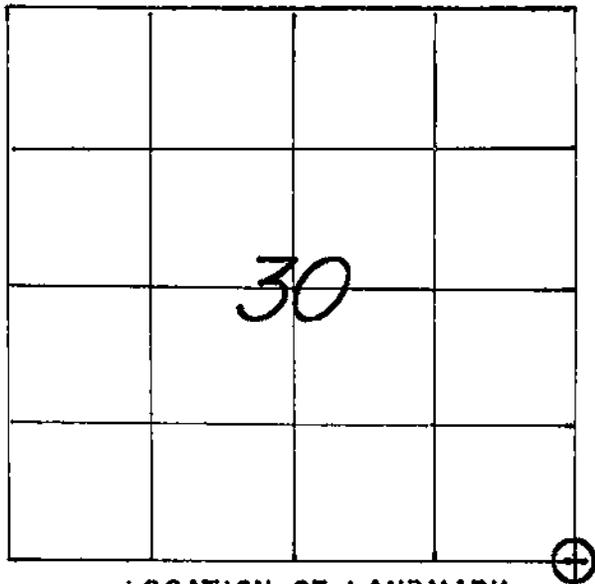

LOCATION OF LANDMARK

CREW: WILLIAM G. JUNG  
PETER F. FOLLANSBEE  
DATE: 9/04/2001

WISCONSIN COORDINATE SYSTEM

North

East

Theta Angle

Horiz. Order

Vert. Order

TYPE OF LANDMARK

*3/4" IRON BAR WITH AN ALUMINUM CAP.*

BEARINGS ARE REFERENCED TO

*ASSUMED NORTH AS PER SECTION DATA.*

Describe any record evidence, monument evidence, testimonial evidence or any other material evidence you considered and whether the monument was found or restored through acceptance of an obliterated evidence location.

I found an iron bar at the old occupied corner. This bar had been used as the corner in previous survey work. I accepted this location as the best available evidence of the original government corner location. I put one of our standard aluminum caps on the existing bar.


Describe or show any material discrepancy between the location of the restored corner and that of the corner previously restored or reestablished.

**NONE KNOWN.**

RECORD OF DURABLE WITNESS MONUMENTS

MAGNETIC


NO	DESCRIPTION	BEARING	DISTANCE
1	SET A NAIL IN N.W.-SIDE OF A 9" ELM	S 34° W	39.99 FT.
2	SET A NAIL IN S.E.-SIDE OF AN 8" ELM	S 60° W	26.46 FT.
3	SET A NAIL IN N.-SIDE OF A 7" TREE	WESTERLY ±	34.35 FT.
4	SET A NAIL IN N.W.-SIDE OF A 6" ELM	N 52° E	20.56 FT.

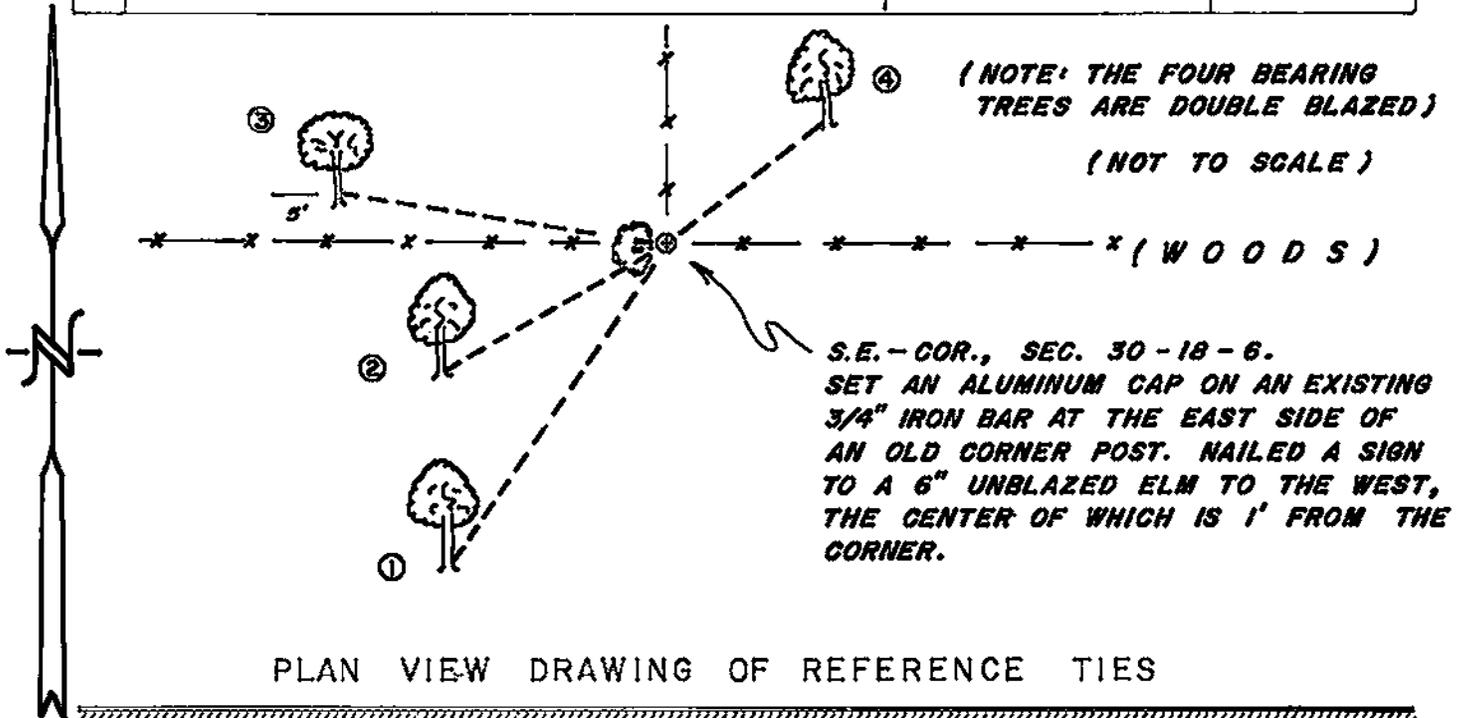

MAP SHOWING DISTANCE AND DIRECTION TO OTHER PUBLIC LAND SURVEY CORNERS USED FOR REESTABLISHING THE CORNER


( R.A. BERG MEASUREMENTS )

( NOT TO SCALE )

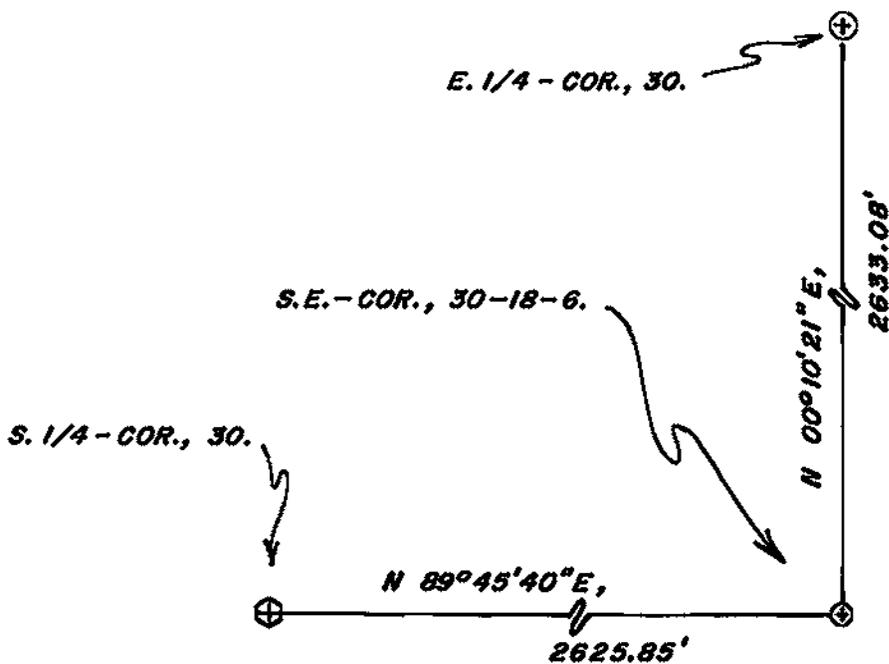

I, WILLIAM C. JUNG, COUNTY SURVEYOR  
HEREBY CERTIFY THAT THE CORNER LOCATION SHOWN ON THIS RECORD WAS DETERMINED BY ME OR UNDER MY DIRECTION AND CONTROL AND THAT THIS U. S. PUBLIC LAND SURVEY MONUMENT RECORD IS CORRECT AND COMPLETE TO THE BEST OF MY KNOWLEDGE AND BELIEF.

William C. Jung 11/20/01  
Signature Date

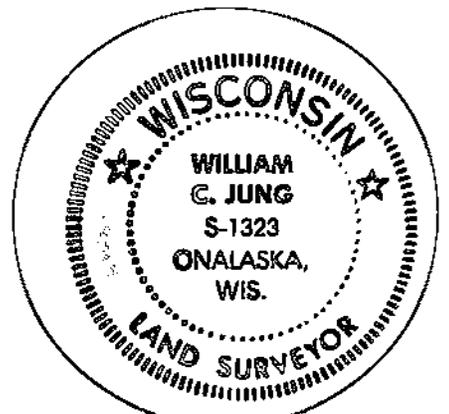

Seal