


## U. S. PUBLIC LAND SURVEY MONUMENT RECORD

SECTION 31 T 18 N, R 6 W, TOWN OF FARMINGTON

LA CROSSE COUNTY

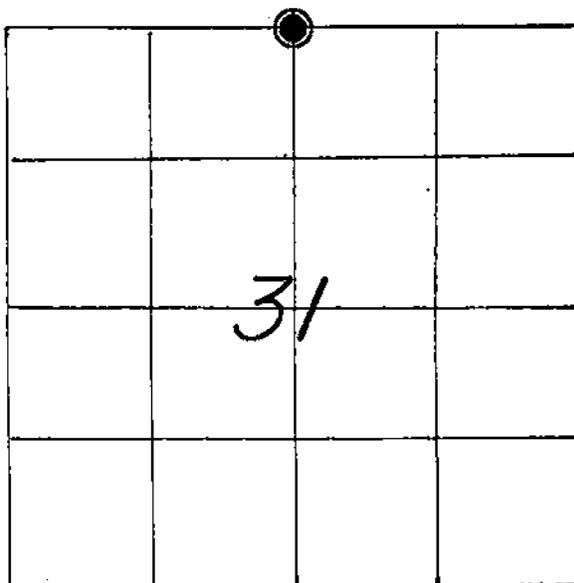

LOCATION OF LANDMARK

CREW: WILLIAM C. JUNG  
 PETER F. FOLLANSBEE  
 DATE: 11/30/1998

## WISCONSIN COORDINATE SYSTEM

North

East

Theta Angle

Horiz. Order

Vert. Order

## TYPE OF LANDMARK

3/4" x 30" I.B. w/ALUM. CAP IN EXIST. I.P.I.P.E.

BEARINGS ARE REFERENCED TO

Describe any record evidence, monument evidence, testimonial evidence or any other material evidence you considered and whether the monument was found or restored through acceptance of an obliterated evidence location.


I found an iron pipe at the occupied corner that had been used in previous survey work. I accepted this location as the best available evidence of the original government corner position. An iron bar with a cap was set inside of the pipe.

Describe or show any material discrepancy between the location of the restored corner and that of the corner previously restored or reestablished.

**NONE KNOWN.**

RECORD OF DURABLE WITNESS MONUMENTS  
MAGNETIC

NO	DESCRIPTION	BEARING	DISTANCE
1	SET A NAIL IN THE N.E.-SIDE 4" HICKORY	N 20° W	10.82 FT.
2	SET A NAIL IN THE W.-SIDE 3" OAK	N 45° E	40.38 FT.
3	SET A NAIL IN THE N.-SIDE 7-1/4" HICKORY	S 41° E	16.31 FT.
4	SET A NAIL IN THE E.-SIDE 24" COTTONWOOD	S 35° W	46.24 FT.

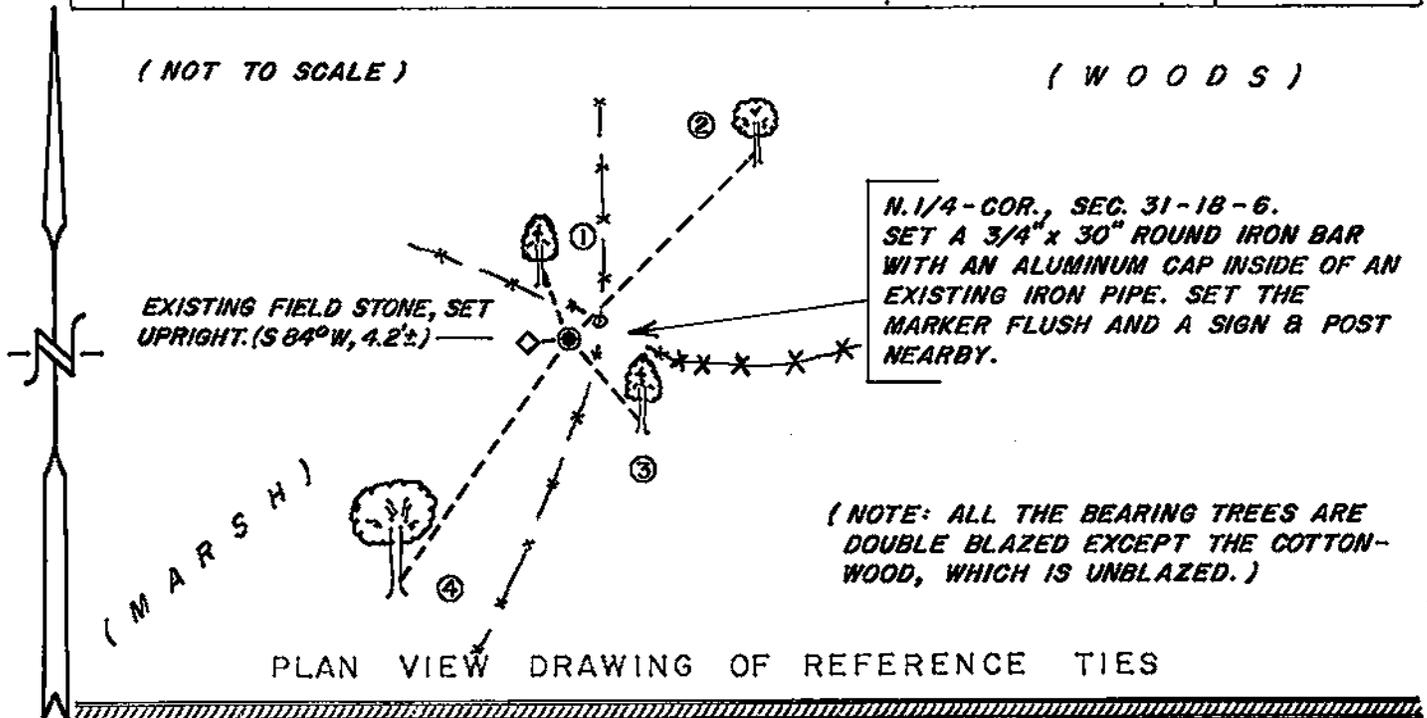


MAP SHOWING DISTANCE AND DIRECTION TO OTHER PUBLIC LAND SURVEY CORNERS USED FOR REESTABLISHING THE CORNER

No section measurements were made by me at this time. The position of this corner was confirmed by others in previous survey work.

I, WILLIAM C. JUNG, COUNTY SURVEYOR  
HEREBY CERTIFY THAT THE CORNER LOCATION SHOWN ON THIS RECORD WAS DETERMINED BY ME OR UNDER MY DIRECTION AND CONTROL AND THAT THIS U. S. PUBLIC LAND SURVEY MONUMENT RECORD IS CORRECT AND COMPLETE TO THE BEST OF MY KNOWLEDGE AND BELIEF.

William C. Jung 12/31/98  
Signature Date

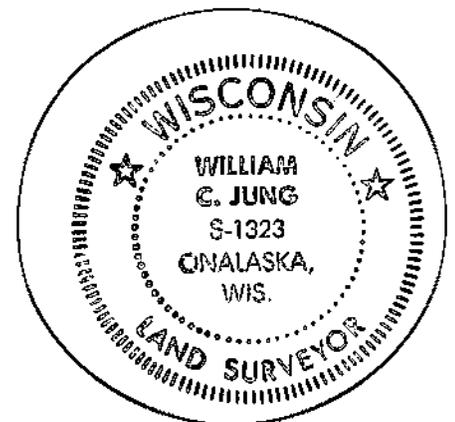

Seal