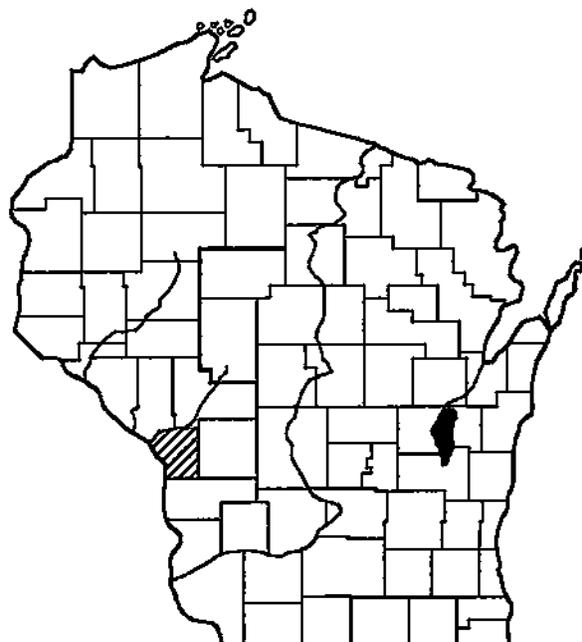
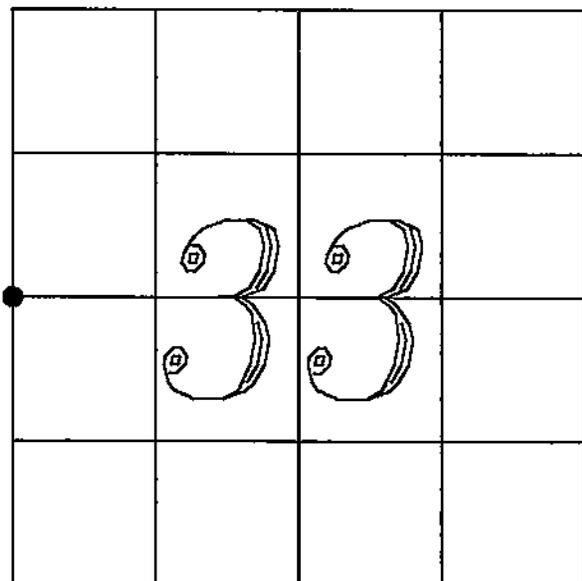


U. S. PUBLIC LAND SURVEY MONUMENT RECORD

**SECTION 33, TOWN 18 NORTH, RANGE 6 WEST
TOWN OF FARMINGTON, LA CROSSE COUNTY**

LANDMARK: EXISTING 1 1/4" O.D. IRON PIPE

WITNESS TO CORNER LOCATION:

Joshua K. Nave
Christopher W. Fechner
William C. Jung

Describe any record evidence, monument evidence, testimonial evidence, or any other material evidence you considered and whether the monument was found or restored through acceptance of an obliterated evidence location.

Found iron pipe as shown on map of survey by K. Don Pederson dated 1982 and revised 1987. Section measurements confirm this position.


Describe or show any material discrepancy between the location of the restored corner and that of the corner previously restored or reestablished.

N/A

RECORD OF DURABLE WITNESS MONUMENTS

NO	DESCRIPTION	BEARING	DISTANCE
1	24" SILVER MAPLE SINGLE BLAZED	S 86°32'33" E	26.19'
2	9" CHERRY SINGLE BLAZED	S 17°58'41" E	28.62'
3	7" CHERRY SINGLE BLAZED	S 43°45'48" W	2.12'
4	26" HICKORY	N 59°13'31" W	33.93'


DISTANCE MEASUREMENTS TO CENTER OF MASS
BEARINGS ARE BASED ON SURVEY PROJECT S-5024

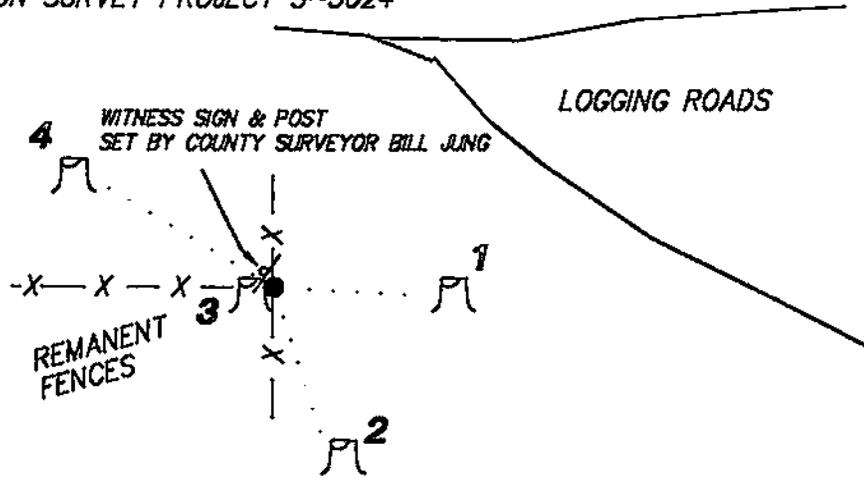

NOT TO SCALE

PLAN VIEW DRAWING OF REFERENCE TIES

MAP SHOWING DISTANCE AND DIRECTION TO OTHER PUBLIC LAND SURVEY CORNERS USED FOR REESTABLISHING THE CORNER

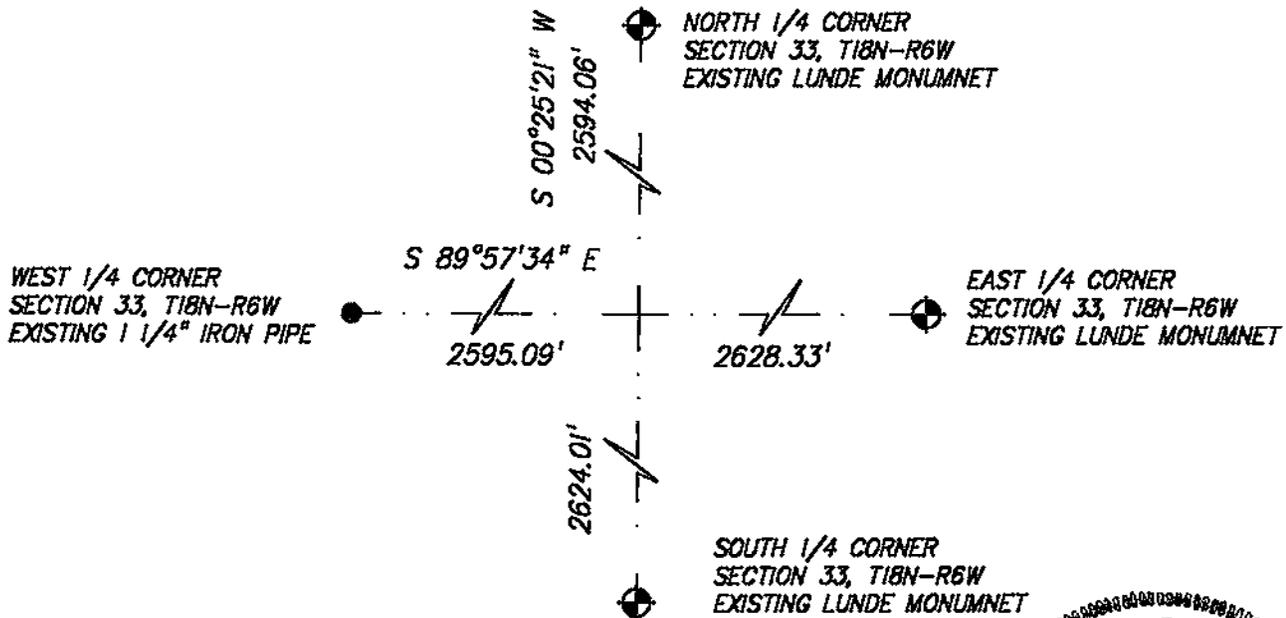

I, JOSHUA K. NAVE RLS# 2653
HEREBY CERTIFY THAT THE CORNER LOCATION SHOWN ON THIS RECORD
WAS DETERMINED BY ME OR UNDER MY DIRECTION AND CONTROL AND
THAT THIS U. S. PUBLIC LAND SURVEY MONUMENT RECORD IS CORRECT
AND COMPLETE TO THE BEST OF MY KNOWLEDGE AND BELIEF.



6/8/04

Signature Date