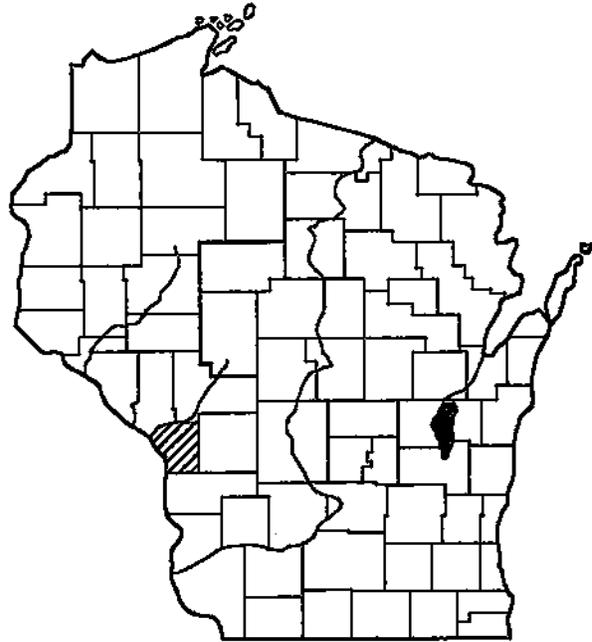
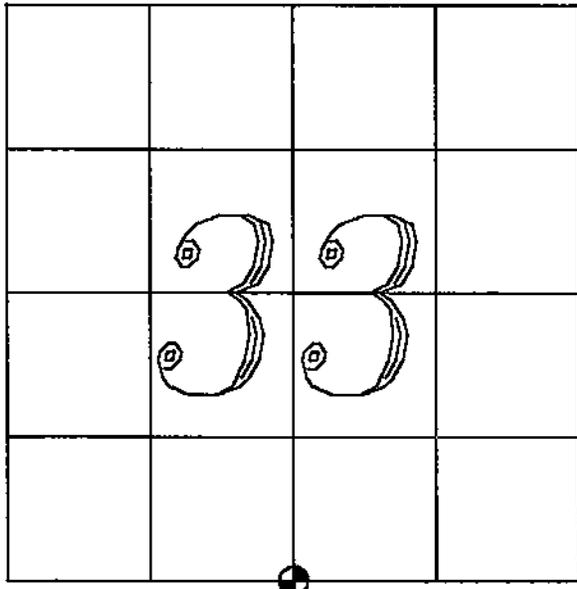


U. S. PUBLIC LAND SURVEY MONUMENT RECORD

**SECTION 33, TOWN 18 NORTH, RANGE 6 WEST
TOWN OF FARMINGTON, LA CROSSE COUNTY**

LANDMARK: SET BRASS CAP LUNDE MONUMENT
BURIED WINE BOTTLE WITH SHELL CASING ON WEST SIDE
WITNESS TO CORNER LOCATION:

*Joshua K. Nave
Christopher W. Fechner
William C. Jung*

Describe any record evidence, monument evidence, testimonial evidence, or any other material evidence you considered and whether the monument was found or restored through acceptance of an obliterated evidence location.

I computed the lost corner position to begin searching for possible corner evidence and its accessories. Preliminary measurements indicated that this position would fit well with interior occupation. Bill Jung, Chris Fechner and I searched for original evidence and found none.

I set this corner at the lost corner position.


Describe or show any material discrepancy between the location of the restored corner and that of the corner previously restored or reestablished.

While completing my survey for Harold Mikkelson and Diane Mikkelson, I found a 5/8" rebar and a 1 1/2" hexagonal iron bar at the occupied northwest corner of the SW 1/4 of the SE 1/4 of Section 33. I set the "40" corner N 19°04'38" E 4.22 feet from the 1 1/2" iron bar. I then returned to the South 1/4 corner of Section 33 and searched at a computed position using said found iron bar. Nothing found.

RECORD OF DURABLE WITNESS MONUMENTS

NO	DESCRIPTION	BEARING	DISTANCE
1	SET 3/4" X 30" IRON BAR	S 89°13'37" E	9.50'
2	SET 3/4" X 30" IRON BAR	S 47°57'11" E	13.93'
3	SET 3/4" X 30" IRON BAR	S 28°08'15" E	42.15'
4	SET 3/4" X 30" IRON BAR	S 11°52'17" E	26.95'

BEARINGS ARE BASED ON SURVEY PROJECT S-5024

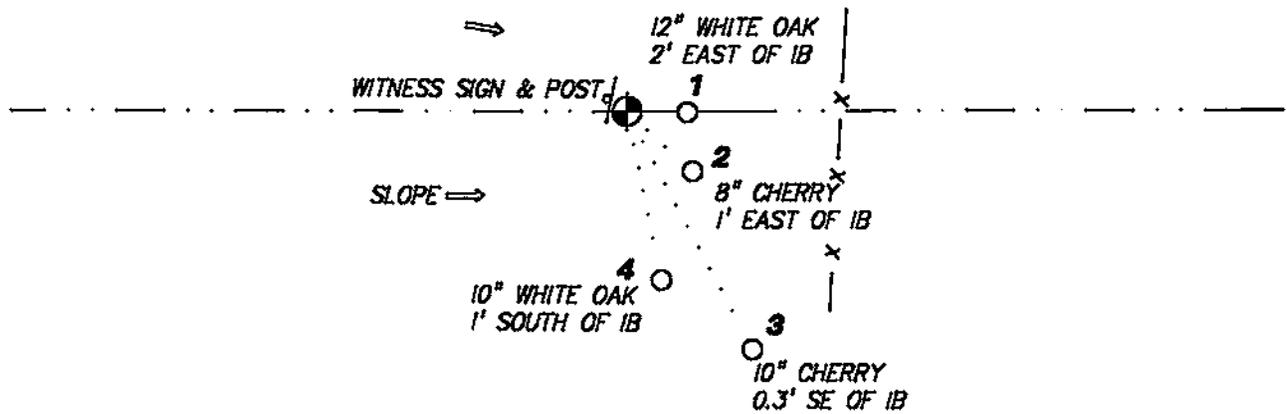

SCALE 1" = 30'

PLAN VIEW DRAWING OF REFERENCE TIES

MAP SHOWING DISTANCE AND DIRECTION TO OTHER PUBLIC LAND SURVEY CORNERS USED FOR REESTABLISHING THE CORNER

SOUTHWEST CORNER
SECTION 33, T18N-R6W
EXISTING 1 1/4" IRON PIPE

SOUTHEAST CORNER
SECTION 33, T18N-R6W
EXISTING BERNTSEN CAPPED IP



SOUTH 1/4 CORNER
SECTION 33, T18N-R6W
SET LUNDE MONUMENT

I, JOSHUA K. NAVE RLS# 2653
HEREBY CERTIFY THAT THE CORNER LOCATION SHOWN ON THIS RECORD
WAS DETERMINED BY ME OR UNDER MY DIRECTION AND CONTROL AND
THAT THIS U. S. PUBLIC LAND SURVEY MONUMENT RECORD IS CORRECT
AND COMPLETE TO THE BEST OF MY KNOWLEDGE AND BELIEF.



6/14/04
 Signature Date