


U. S. PUBLIC LAND SURVEY MONUMENT RECORD

SECTION 33 T 18 N, R 6 W, TOWN OF FARMINGTON

LA CROSSE COUNTY

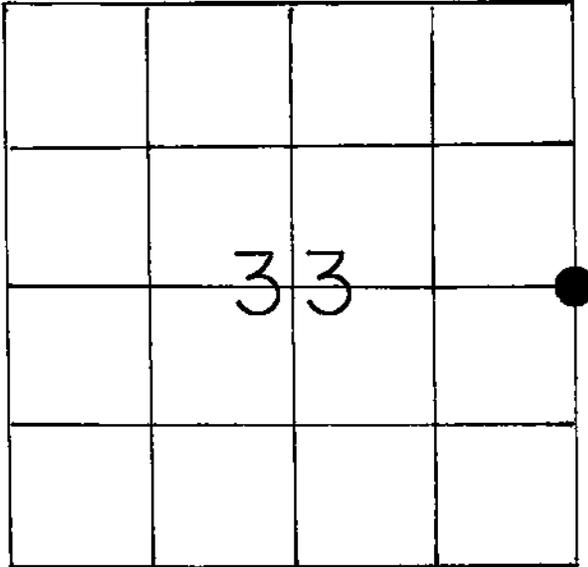

LOCATION OF LANDMARK

Crew: William C. Jung
Peter F. Follansbee

Date: April 13, 1992

Describe any record evidence, monument evidence, testimonial evidence or any other material evidence you considered and whether the monument was found or restored through acceptance of an obliterated evidence location.

I found an iron pipe at the old occupied fence corner. This location had been used as the corner in previous survey work. I accepted the location as the best available evidence of the original government corner position. The pipe was replaced with a Lunde marker. The Lunde is up 5". South of the Lunde is a sign and post and buried on the West side is a bottle with a shell casing.

Describe or show any material discrepancy between the location of the restored corner and that of the corner previously restored or reestablished.

None known.

WISCONSIN COORDINATE SYSTEM

North

East

Theta Angle

Horiz. Order

Vert. Order


TYPE OF LANDMARK

Brass capped Lunde marker

BEARINGS ARE REFERENCED TO

RECORD OF DURABLE WITNESS MONUMENTS

NO	DESCRIPTION	BEARING	DISTANCE
1	P.K. nail in double blazed 10" white oak	-----	19.35
2	" 4" hickory	-----	6.16
3	" 14" oak	-----	11.22
4	" 16" oak	-----	35.57

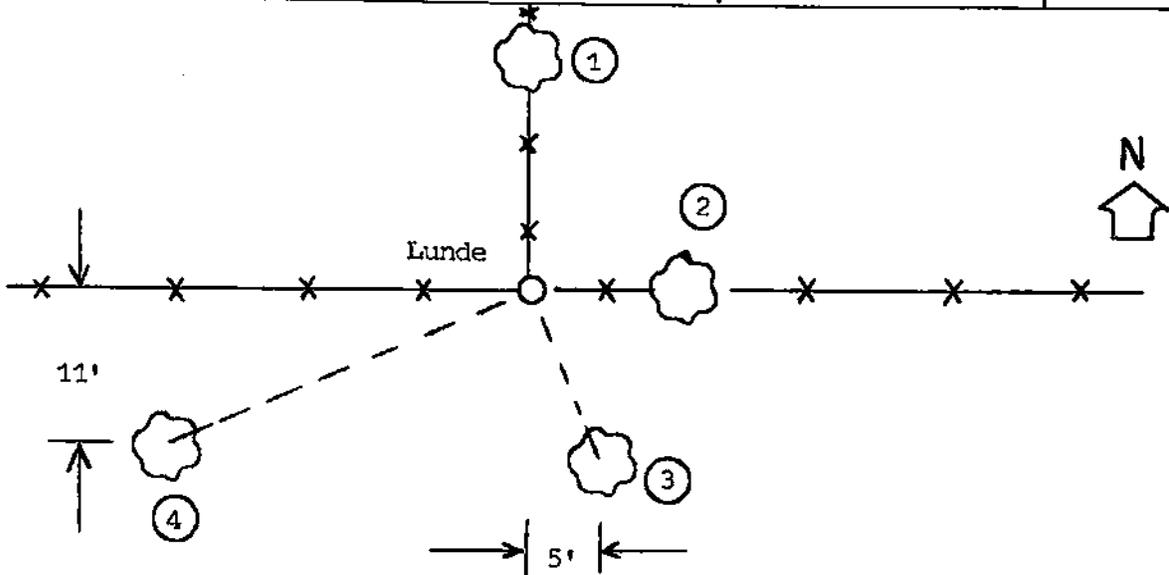

(not to scale)

PLAN VIEW DRAWING OF REFERENCE TIES


MAP SHOWING DISTANCE AND DIRECTION TO OTHER PUBLIC LAND SURVEY CORNERS USED FOR REESTABLISHING THE CORNER

No section measurements made by me at this time. Solberg's 1/2 mile distance to the South to the section corner is short, but is consistent with what I have found in this part of the county.

I, William C. Jung, Deputy County Surveyor,
 HEREBY CERTIFY THAT THE CORNER LOCATION SHOWN ON THIS RECORD
 WAS DETERMINED BY ME OR UNDER MY DIRECTION AND CONTROL AND
 THAT THIS U. S. PUBLIC LAND SURVEY MONUMENT RECORD IS CORRECT
 AND COMPLETE TO THE BEST OF MY KNOWLEDGE AND BELIEF.

William C. Jung
 Signature

June 2, 1992
 Date

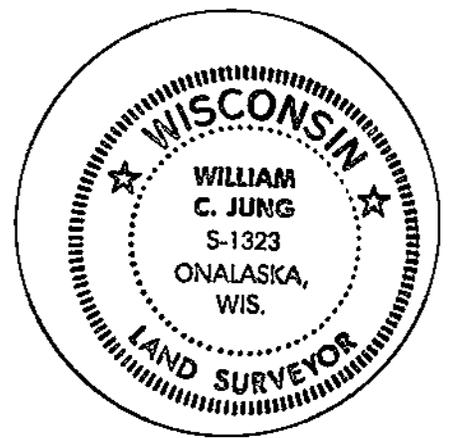

Seal