


U. S. PUBLIC LAND SURVEY MONUMENT RECORD

SECTION 35 T 18 N, R 6 W, TOWN OF FARMINGTON
 LA CROSSE COUNTY

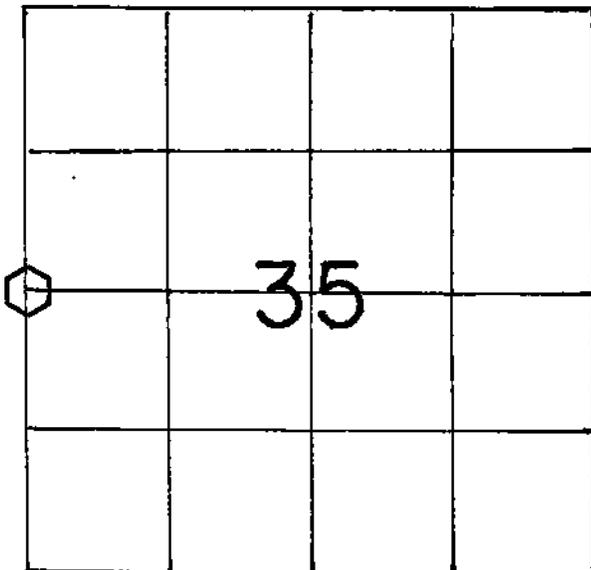

LOCATION OF LANDMARK

Crew: WILLIAM C. JUNG
 PETER F. FOLLANSBEE

Date: 12/20/1994

Describe any record evidence, monument evidence, testimonial evidence or any other material evidence you considered and whether the monument was found or restored through acceptance of an obliterated evidence location.

I set the corner in the old East-West line fence and on line with the section corners and monumented it with a brass capped Lunde marker.

Describe or show any material discrepancy between the location of the restored corner and that of the corner previously restored or reestablished.

None Known.

WISCONSIN COORDINATE SYSTEM

North

East

Theta Angle

Horiz. Order

Vert. Order

TYPE OF LANDMARK


Set brass cap Lunde marker.

BEARINGS ARE REFERENCED TO


True North.

RECORD OF DURABLE WITNESS MONUMENTS

NO	DESCRIPTION	MAGNETIC	
		BEARING	DISTANCE
1	Flathead Bolt survey point	S 88° W	17.57 Ft.
2	Set P.K. Nail in SW-side 4" Hickory	N 58° W	13.21 Ft.
3	Set P.K. Nail in NE-side 4½" Hickory	S 17° E	3.37 Ft.
4	Set P.K. Nail in W.-side 6" Hickory	S 15° W	7.87 Ft.

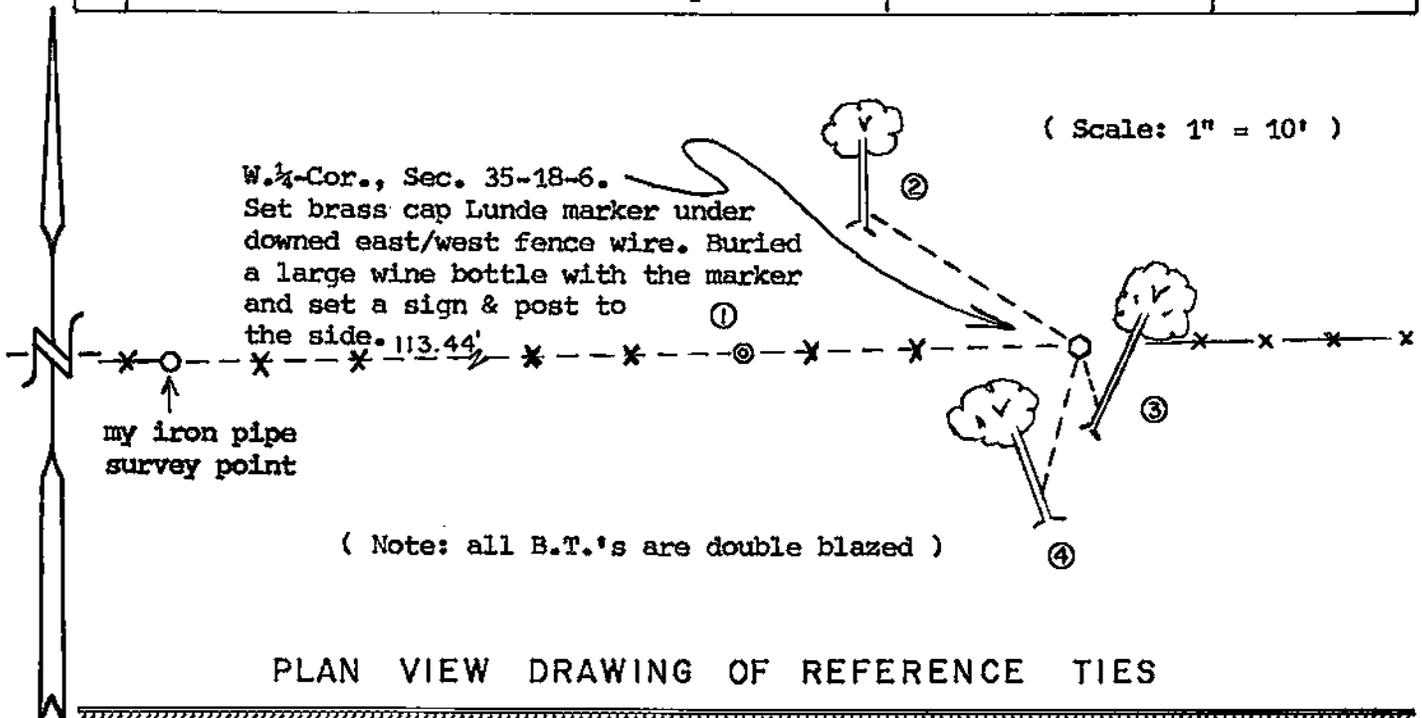

MAP SHOWING DISTANCE AND DIRECTION TO OTHER PUBLIC LAND SURVEY CORNERS USED FOR REESTABLISHING THE CORNER (not to scale)

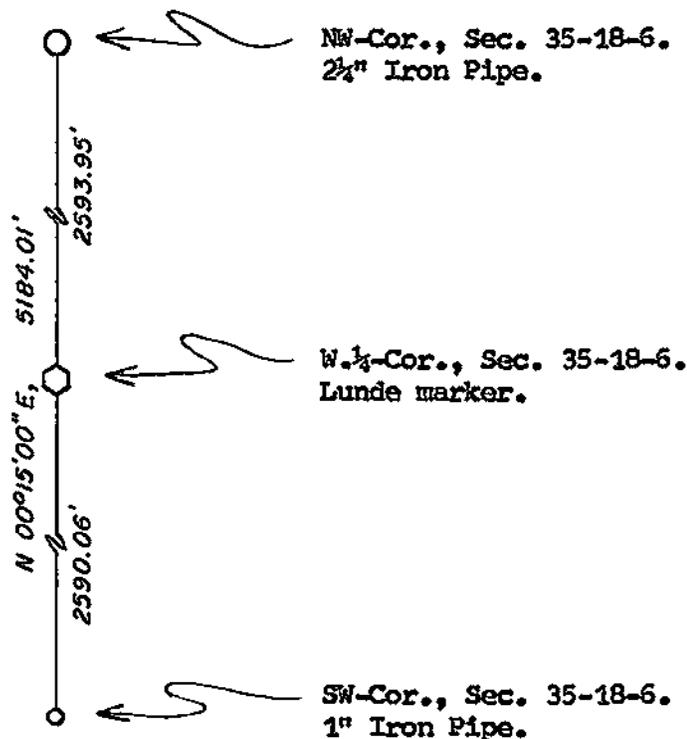

I, William C. Jung, County Surveyor
HEREBY CERTIFY THAT THE CORNER LOCATION SHOWN ON THIS RECORD
WAS DETERMINED BY ME OR UNDER MY DIRECTION AND CONTROL AND
THAT THIS U. S. PUBLIC LAND SURVEY MONUMENT RECORD IS CORRECT
AND COMPLETE TO THE BEST OF MY KNOWLEDGE AND BELIEF.

William C. Jung 2/8/95
Signature Date



Seal