


U. S. PUBLIC LAND SURVEY MONUMENT RECORD

SECTION 35 T 18 N, R 6 W, TOWN OF FARMINGTON
 LA CROSSE COUNTY

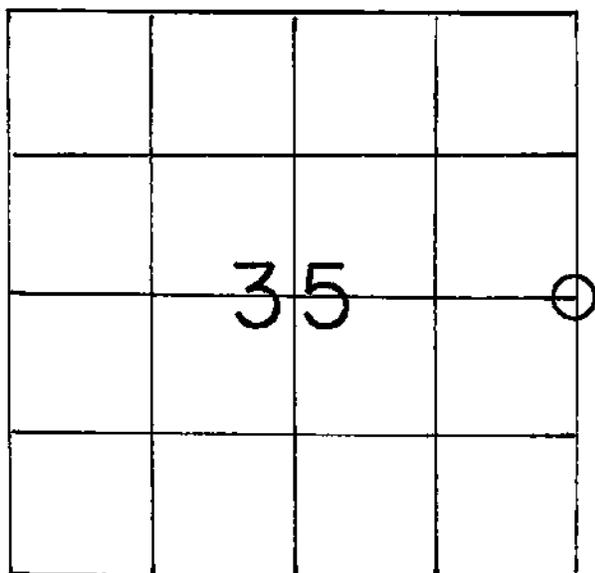

LOCATION OF LANDMARK

WISCONSIN COORDINATE SYSTEM

North
 East
 Theta Angle
 Horiz. Order
 Vert. Order

TYPE OF LANDMARK
 Set 2 1/4" x 28 1/2" Iron Pipe

BEARINGS ARE REFERENCED TO
 True North.

Crew: WILLIAM C. JUNG
 PETER F. FOLLANSBEE

Date: 12/06/1994
 12/08/1994

Describe any record evidence, monument evidence, testimonial evidence or any other material evidence you considered and whether the monument was found or restored through acceptance of an obliterated evidence location.


I set this corner by single proportionate measurement and monumented it with an iron pipe.

Describe or show any material discrepancy between the location of the restored corner and that of the corner previously restored or reestablished.

None Known.


RECORD OF DURABLE WITNESS MONUMENTS
MAGNETIC

NO	DESCRIPTION	BEARING	DISTANCE
1	Set P.K. Nail in SW-side 7" W. Pine(unblazed)	N 23° W	SL.=186.72'
2	Set P.K. Nail in SW-side 8" W. Pine(unblazed)	N 35° W	SL.=162.80'
3	Set 5/8" x 13" Rebar near fence corner	N 71° W	41.65 Ft.
4	Set 5/8" x 13" Rebar northwest of culvert	N 71° W	15.63 Ft.

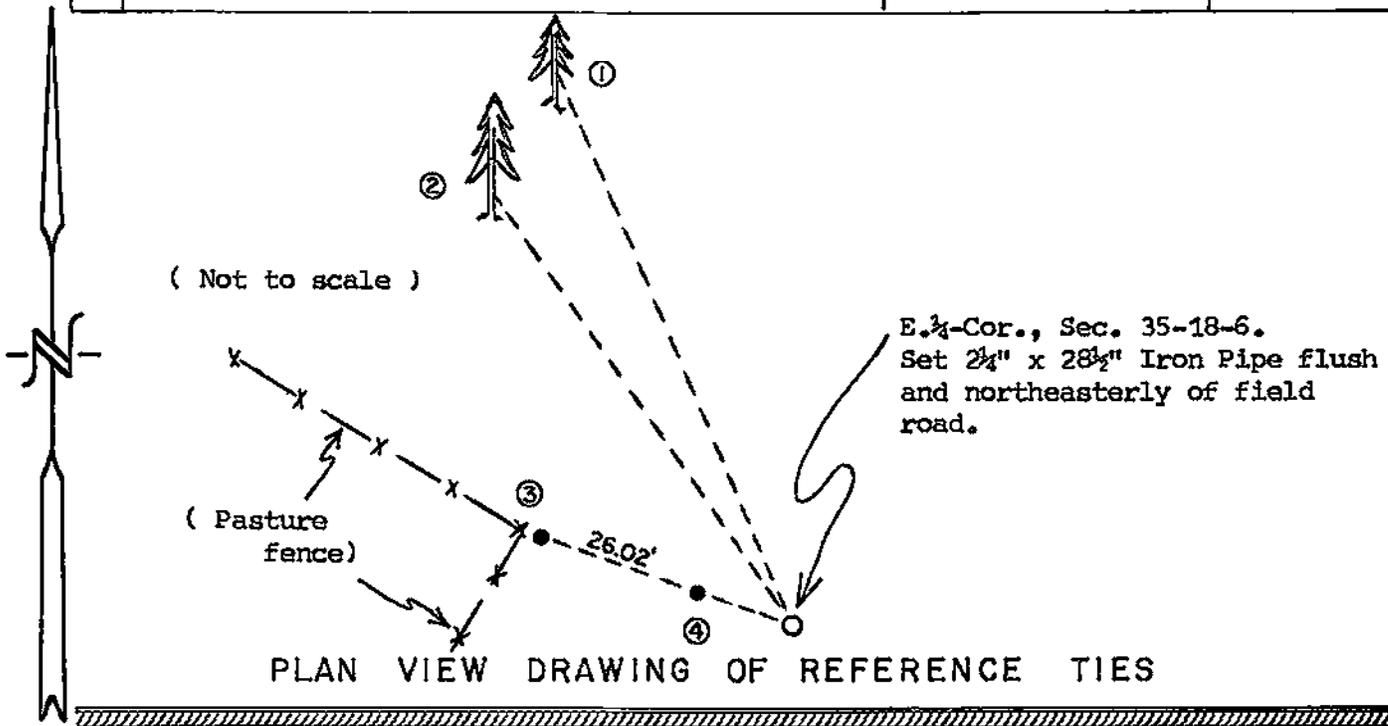

MAP SHOWING DISTANCE AND DIRECTION TO OTHER PUBLIC LAND SURVEY CORNERS USED FOR REESTABLISHING THE CORNER


(not to scale)

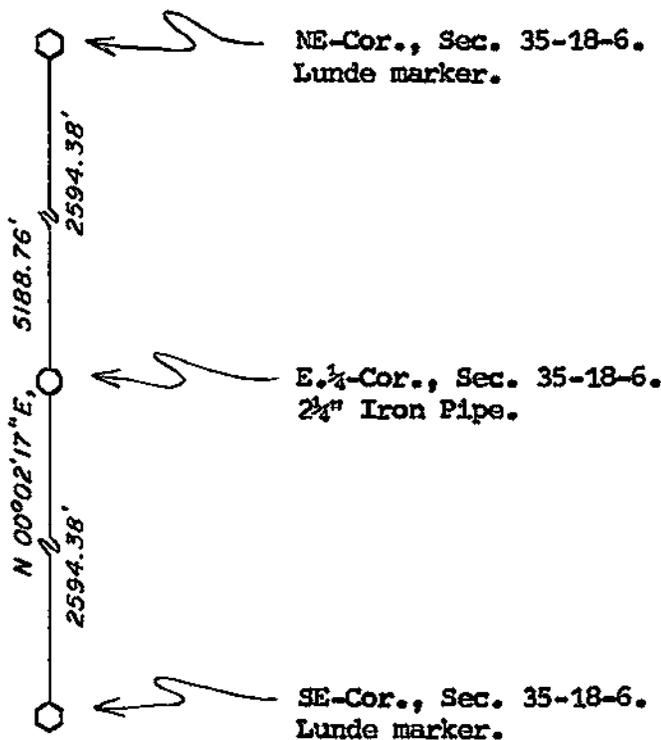

I, William C. Jung, County Surveyor
HEREBY CERTIFY THAT THE CORNER LOCATION SHOWN ON THIS RECORD WAS DETERMINED BY ME OR UNDER MY DIRECTION AND CONTROL AND THAT THIS U. S. PUBLIC LAND SURVEY MONUMENT RECORD IS CORRECT AND COMPLETE TO THE BEST OF MY KNOWLEDGE AND BELIEF.

William C. Jung
Signature

2/8/95
Date

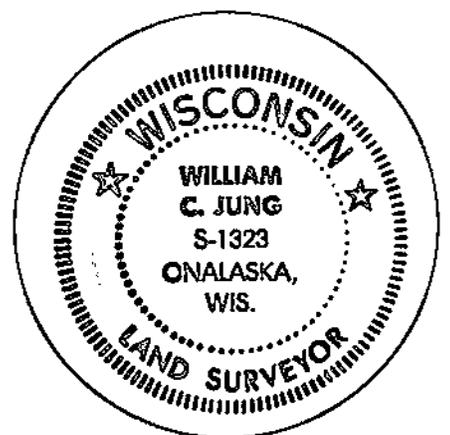

Seal