


21806362000

U. S. PUBLIC LAND SURVEY MONUMENT RECORD

SECTION 36 T 18 N, R 6 W, TOWN OF FARMINGTON

LA CROSSE COUNTY

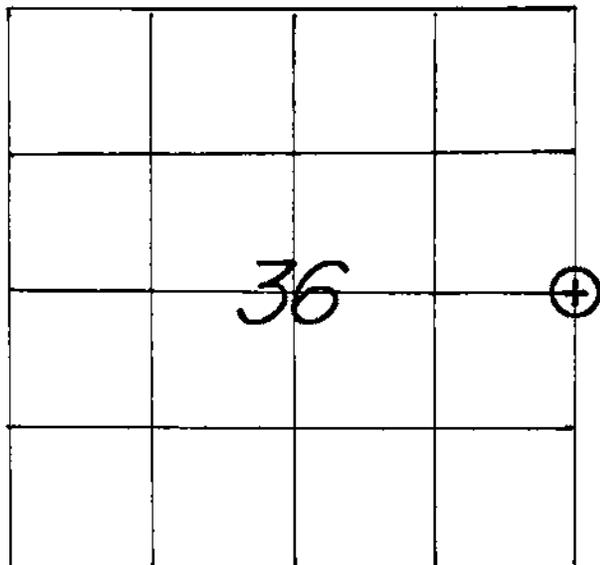

WISCONSIN COORDINATE SYSTEM

North

East

Theta Angle

Horiz. Order

Vert. Order

TYPE OF LANDMARK

3/4" x 30" IRON BAR WITH ALUMINUM CAP.

BEARINGS ARE REFERENCED TO

TRUE NORTH AS PER SECTION DATA.

LOCATION OF LANDMARK

CREW: *WILLIAM C. JUNG*
PETER F. FOLLANSBEE
 DATE: *9/27/2001*

Describe any record evidence, monument evidence, testimonial evidence or any other material evidence you considered and whether the monument was found or restored through acceptance of an obliterated evidence location.

After discussing this corner at great length, Norm Hurlburt and I agreed that this corner should be set by single proportionate measurement. We tied off our iron bar and cap that Norm had set at an earlier date.

Describe or show any material discrepancy between the location of the restored corner and that of the corner previously restored or reestablished.

NONE KNOWN.

RECORD OF DURABLE WITNESS MONUMENTS
MAGNETIC

NO	DESCRIPTION	BEARING	DISTANCE
1	SET A NAIL IN E.-SIDE OF A 9" WHITE OAK	N 18° W	23.79 FT.
2	SET A NAIL IN S.E.-SIDE OF A 12-1/2" WHITE OAK	N 48° E	25.12 FT.
3	SET A NAIL IN S.E.-SIDE OF A 6" WHITE OAK	S 07° W	14.01 FT.
4	SET A NAIL IN S.E.-SIDE OF A 13-1/2" WHITE OAK	S 69° W	25.26 FT.

(NOTE: THE FOUR BEARING TREES ARE DOUBLE BLAZED.)

E. 1/4 - COR., SEC. 36-18-6.
EXISTING 3/4" x 30" IRON BAR
WITH AN ALUMINUM CAP SET
BY N.R. HURLBURT. THE
CORNER FALL APPROXIMATELY
14 FEET WEST OF THE FENCE.


N 03° E, 5.4' TO THE
CENTER OF A DOUBLE
BLAZED 7" WHITE OAK.
NAILED A SIGN TO
THIS TREE.

(NOT TO SCALE)

PLAN VIEW DRAWING OF REFERENCE TIES

MAP SHOWING DISTANCE AND DIRECTION TO OTHER PUBLIC LAND SURVEY CORNERS USED FOR REESTABLISHING THE CORNER

(N.R. HURLBURT MEASUREMENTS)
(TRUE BEARINGS)
(NOT TO SCALE)

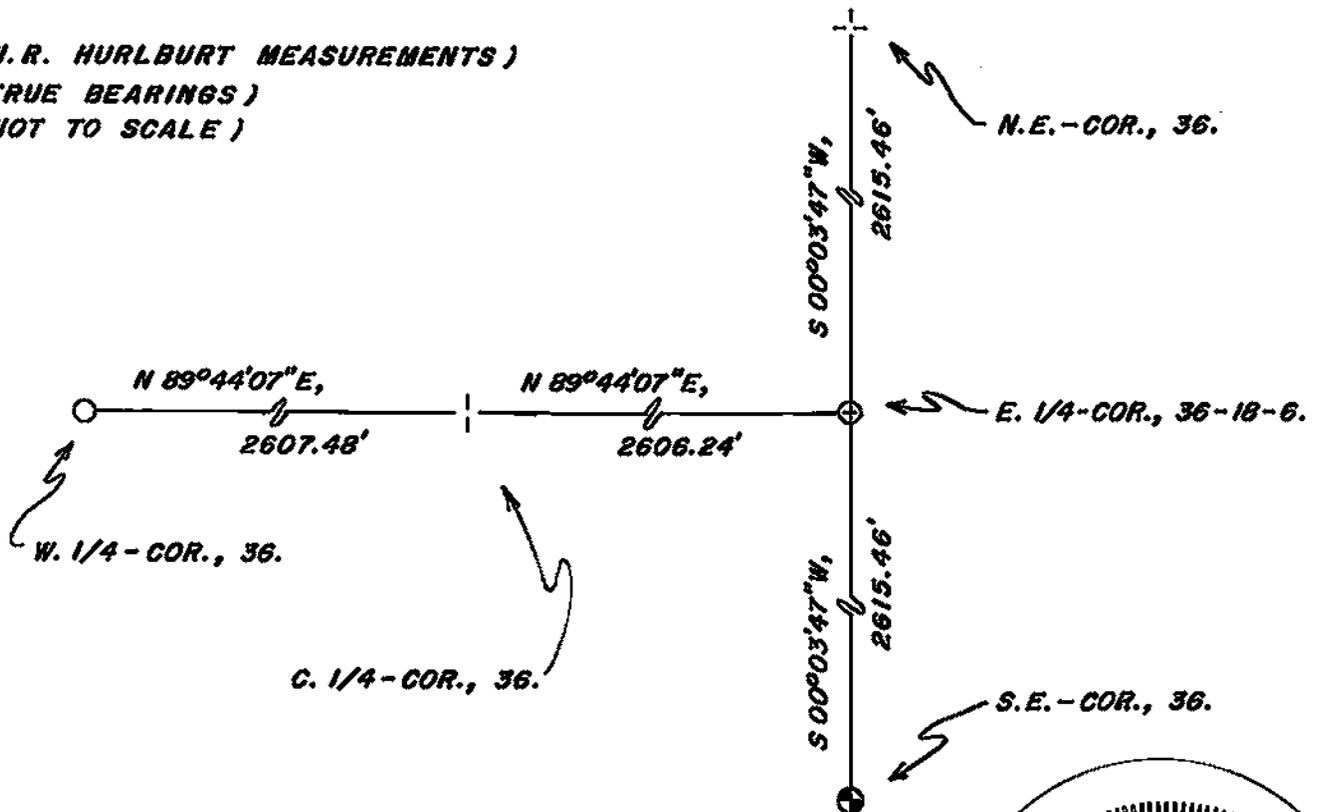

I, WILLIAM C. JUNG, COUNTY SURVEYOR
HEREBY CERTIFY THAT THE CORNER LOCATION SHOWN ON THIS RECORD
WAS DETERMINED BY ME OR UNDER MY DIRECTION AND CONTROL AND
THAT THIS U. S. PUBLIC LAND SURVEY MONUMENT RECORD IS CORRECT
AND COMPLETE TO THE BEST OF MY KNOWLEDGE AND BELIEF.

William C. Jung 1/31/02
Signature Date



Seal