


21807120000

U. S. PUBLIC LAND SURVEY MONUMENT RECORD

SECTION 7 T 18 N, R 6 W, TOWN OF FARMINGTON
 LA CROSSE COUNTY

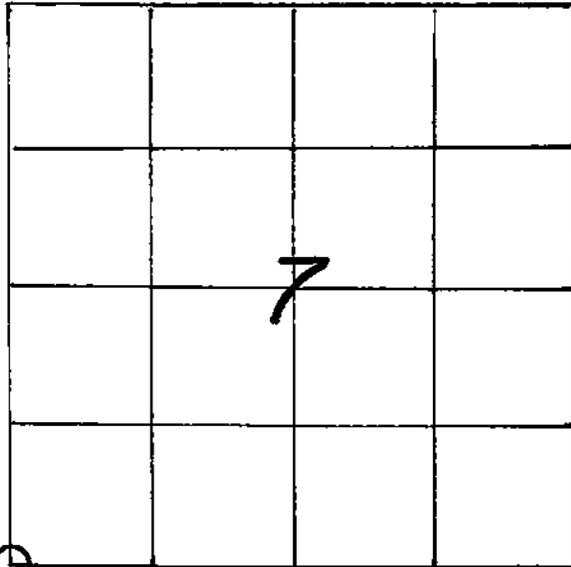

LOCATION OF LANDMARK

Crew: WILLIAM C. JUNG
 PETER F. FOLLANSBEE
 Date: 3/21/1996

Describe any record evidence, monument evidence, testimonial evidence or any other material evidence you considered and whether the monument was found or restored through acceptance of an obliterated evidence location.

I found an existing pipe at the occupied corner. This pipe has been used in previous survey work. I accepted this location as the best available evidence of the original government corner position.

Describe or show any material discrepancy between the location of the restored corner and that of the corner previously restored or reestablished.

None Known.

WISCONSIN COORDINATE SYSTEM

North

East

Theta Angle

Horiz. Order

Vert. Order


TYPE OF LANDMARK

Existing 1-3/4" Iron Pipe.

BEARINGS ARE REFERENCED TO

RECORD OF DURABLE WITNESS MONUMENTS
MAGNETIC

NO	DESCRIPTION	BEARING	DISTANCE
1	Set P.K. Nail in NW-side 19" Burr Oak	S 31°W	39.27 Ft.
2	Set P.K. Nail in S.-side 9" Cedar	East	Sl.=73.44'
3	Set P.K. Nail in SW-side 10" Hickory	S 71°E	Sl.=56.19'
4	Set P.K. Nail in W.-side 40" Burr Oak	South	95.34 Ft.

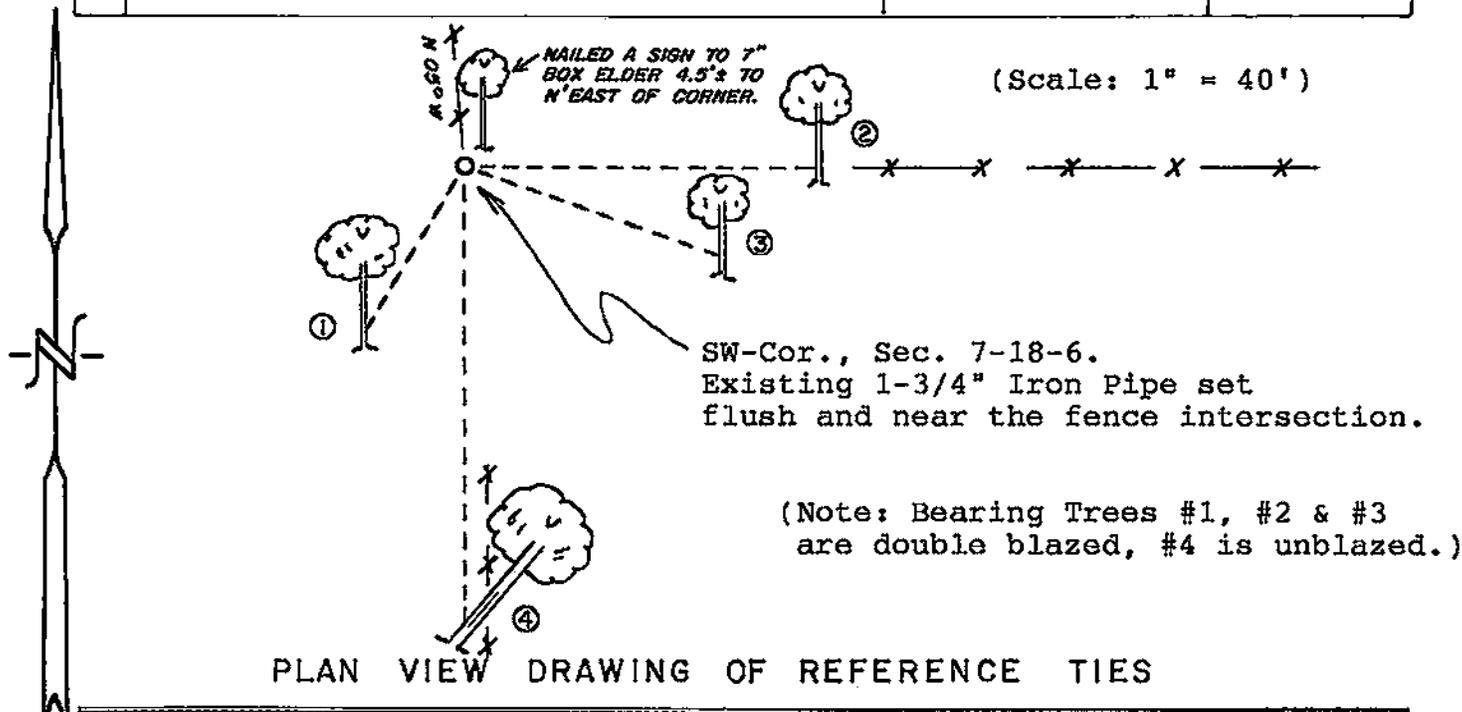

MAP SHOWING DISTANCE AND DIRECTION TO OTHER PUBLIC LAND
SURVEY CORNERS USED FOR REESTABLISHING THE CORNER

No section measurements were made by me at this time. This position was confirmed
by previous survey work.

I, William C. Jung, County Surveyor
HEREBY CERTIFY THAT THE CORNER LOCATION SHOWN ON THIS RECORD
WAS DETERMINED BY ME OR UNDER MY DIRECTION AND CONTROL AND
THAT THIS U. S. PUBLIC LAND SURVEY MONUMENT RECORD IS CORRECT
AND COMPLETE TO THE BEST OF MY KNOWLEDGE AND BELIEF.

William C. Jung 12/2/96
Signature Date



Seal