


U. S. PUBLIC LAND SURVEY MONUMENT RECORD

SECTION 30 T 18 N, R 6 W, TOWN OF FARMINGTON

LA CROSSE COUNTY

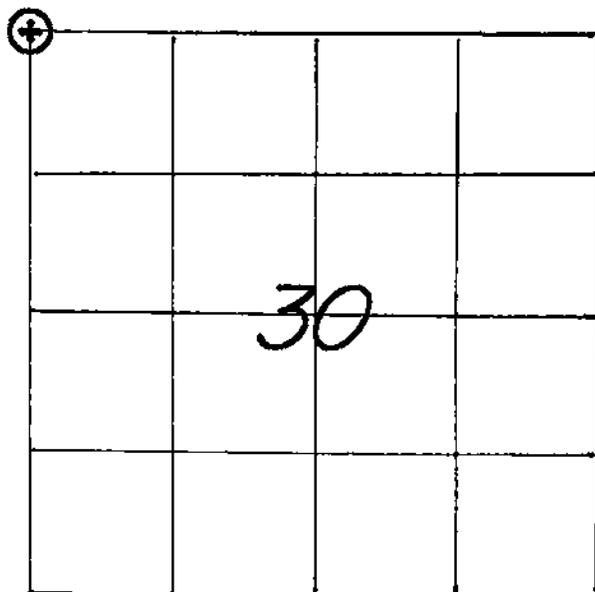

WISCONSIN COORDINATE SYSTEM

North

East

Theta Angle

Horiz. Order

Vert. Order

TYPE OF LANDMARK

*3/4" x 30" IRON BAR WITH AN ALUMINUM CAP*BEARINGS ARE REFERENCED TO
ASSUMED NORTH AS PER SECTION DATA.

LOCATION OF LANDMARK

CREW: *WILLIAM C. JUNG**PETER F. FOLLANSBEE*DATE: *8/31/2001*

Describe any record evidence, monument evidence, testimonial evidence or any other material evidence you considered and whether the monument was found or restored through acceptance of an obliterated evidence location.

After Dick Berg surveyed out Section 30, he and I agreed that the occupied corner should be accepted as the best available evidence of the original government corner position. I removed his spike and replaced it with an iron bar with a cap.

Describe or show any material discrepancy between the location of the restored corner and that of the corner previously restored or reestablished.

NONE KNOWN.

