


21807242000

U. S. PUBLIC LAND SURVEY MONUMENT RECORD

SECTION 19 T 18 N, R 6 W, TOWN OF FARMINGTON
 LA CROSSE COUNTY

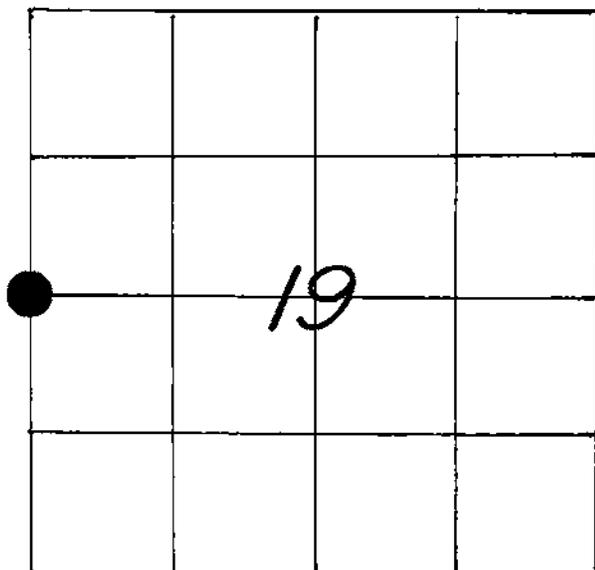

WISCONSIN COORDINATE SYSTEM
North
East
Theta Angle
Horiz. Order
Vert. Order
TYPE OF LANDMARK
3/4" IRON BAR. w/P.K. nail and cap over it
BEARINGS ARE REFERENCED TO

LOCATION OF LANDMARK

CREW: **WILLIAM C. JUNG**
PETER F. FOLLANSBEE
 DATE: **10/09/2001**

Crew: William C. Jung
 Peter F. Follansbee
 Date: 4/29/04

Describe any record evidence, monument evidence, testimonial evidence or any other material evidence you considered and whether the monument was found or restored through acceptance of an obliterated evidence location.

Dick Berg set this "by law" at the single proportionate position. After discussing this with him, I agree. I tied off the iron bar that he set at the corner.


4/29/04 - This section of road was repaved last year. With the metal detector we could "hear" the iron bar below the surface, but it appeared to be knocked off plumb. The asphalt mix was very hard. We set a P.K. nail and cap at the corner over the bar.

Describe or show any material discrepancy between the location of the restored corner and that of the corner previously restored or reestablished.

NONE KNOWN.

RECORD OF DURABLE WITNESS MONUMENTS

	NO	DESCRIPTION	BEARING	DISTANCE
Fd.	1	SET AN 18" ROUNDHEAD BOLT 3'± E. OF PAVEMENT	S.'EASTERLY ±	34.09 FT.
Fd.	2	SET AN 18" ROUNDHEAD BOLT 3'± W. OF PAVEMENT	S.'WESTERLY ±	40.92 FT.
Fd.	3	SET AN 18" ROUNDHEAD BOLT 3'± N. OF PAVEMENT	NORTH ±	18.61 FT.
Fd.	4	SET A 3/4" x 30" IRON BAR WITH RED PLASTIC CAP	S.'EASTERLY ±	40.14 FT.

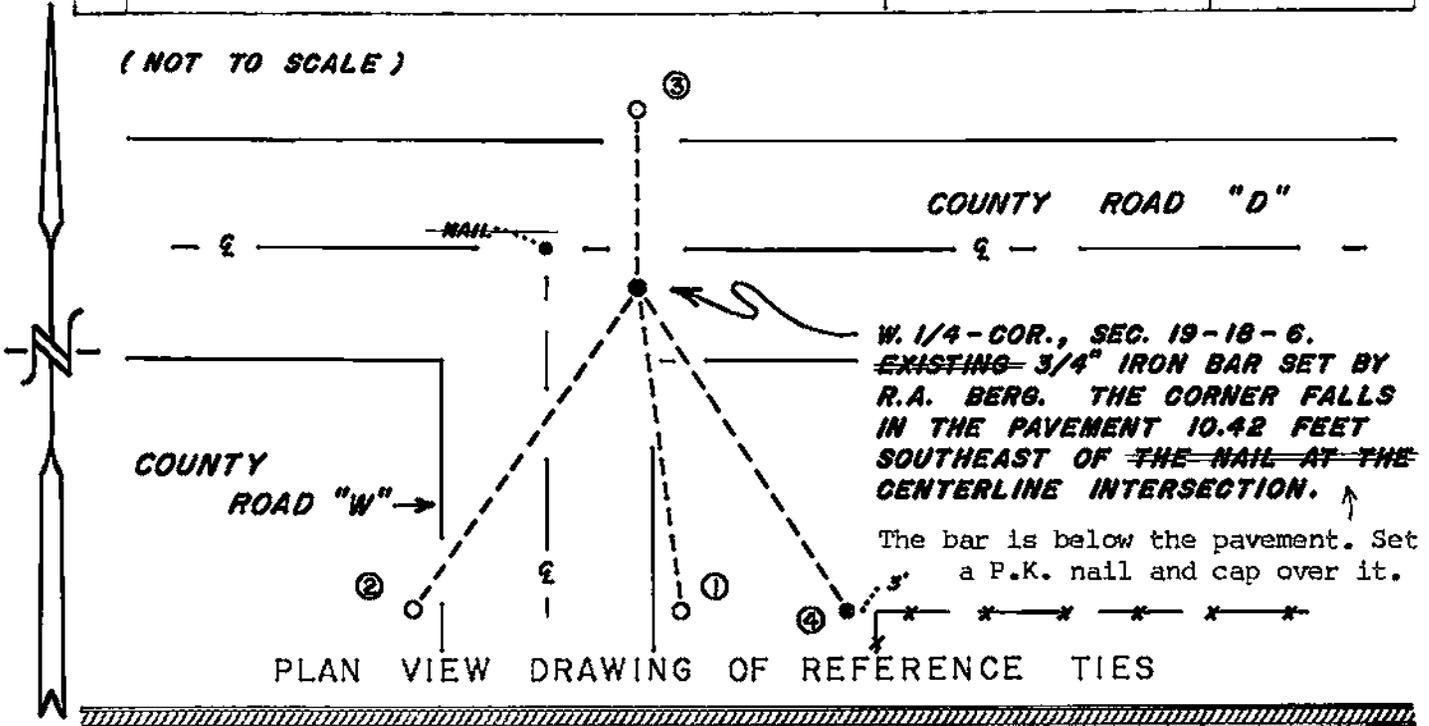


MAP SHOWING DISTANCE AND DIRECTION TO OTHER PUBLIC LAND SURVEY CORNERS USED FOR REESTABLISHING THE CORNER

No section measurements were made by me at this time. Dick Berg confirmed this location with his section data.

I, WILLIAM C. JUNG, COUNTY SURVEYOR
 HEREBY CERTIFY THAT THE CORNER LOCATION SHOWN ON THIS RECORD WAS DETERMINED BY ME OR UNDER MY DIRECTION AND CONTROL AND THAT THIS U. S. PUBLIC LAND SURVEY MONUMENT RECORD IS CORRECT AND COMPLETE TO THE BEST OF MY KNOWLEDGE AND BELIEF.

William C. Jung 1/3/02
 Signature Date

Revised: 1/24/05

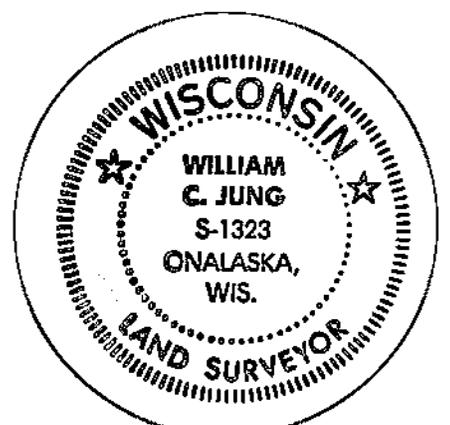

Seal