


21807250000

U. S. PUBLIC LAND SURVEY MONUMENT RECORD

SECTION 31 T 18 N, R 6 W, TOWN OF FARMINGTON

LA CROSSE COUNTY

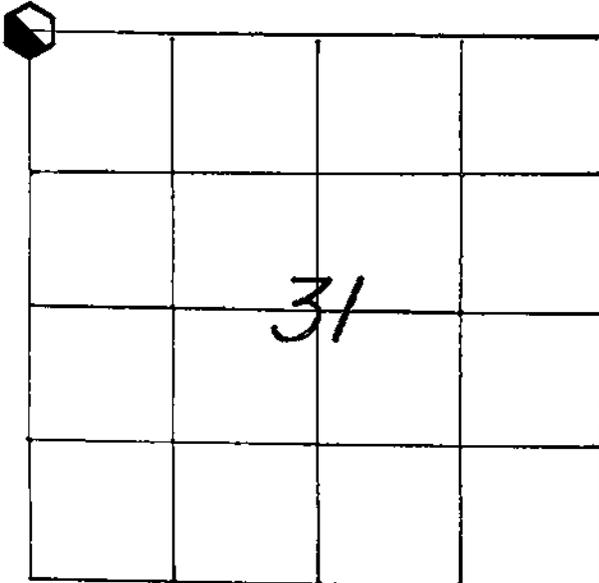

LOCATION OF LANDMARK

CREW: **WILLIAM G. JUNG**
PETER F. FOLLANSBEE
 DATE: **10/10/2006**

WISCONSIN COORDINATE SYSTEM

North **730,902.474**East **1,665,621.997**

Theta Angle

Horiz. Order

Vert. Order

DATUM: **1983('91)**

TYPE OF LANDMARK

30" ALUMINUM BERNTSEN MARKER.

BEARINGS ARE REFERENCED TO
GRID NORTH AS PER SECTION DATA.

Describe any record evidence, monument evidence, testimonial evidence or any other material evidence you considered and whether the monument was found or restored through acceptance of an obliterated evidence location.

I found an old occupied fence corner and accepted it as the best available evidence of the original government corner position. There was an older downed and rotted wood post with tie wire around it near the fence corner. I monumented the corner with a Berntsen marker. It would appear that the newer post was set by or at the location of the downed post. I could find no evidence of the four original bearing trees.

Describe or show any material discrepancy between the location of the restored corner and that of the corner previously restored or reestablished.

NONE KNOWN.

