


21906310000

## U. S. PUBLIC LAND SURVEY MONUMENT RECORD

SECTION 6 T 18 N, R 6 W, TOWN OF FARMINGTON  
LA CROSSE COUNTY

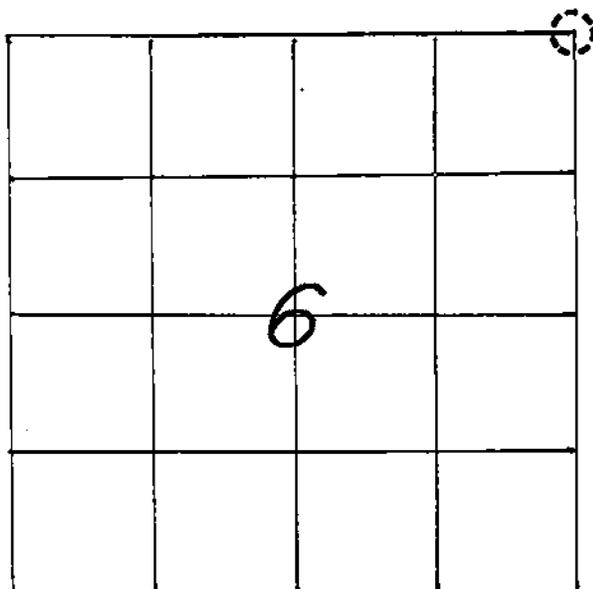

LOCATION OF LANDMARK

CREW: **WILLIAM C. JUNG**  
**PETER F. FOLLANSBEE**  
DATE: **2/07/2002**

## WISCONSIN COORDINATE SYSTEM

North **756,874.838**East **1,670,850.835**

Theta Angle

Horiz. Order

Vert. Order

DATUM: **1983 ('91)**

TYPE OF LANDMARK

**NO MARKER SET.**

BEARINGS ARE REFERENCED TO

**GRID NORTH AS PER SECTION DATA.**

Describe any record evidence, monument evidence, testimonial evidence or any other material evidence you considered and whether the monument was found or restored through acceptance of an obliterated evidence location.

The location of this corner was computed out as the single proportionate measurement position between the North 1/4 corner of Section 5 and the NW corner of Section 6. I believe that this corner now falls in the water. I could not get back to the corner to verify this however because of spring high water. We'd have to go back in the winter to check on this.

Describe or show any material discrepancy between the location of the restored corner and that of the corner previously restored or reestablished.

**NONE KNOWN.**

