


U. S. PUBLIC LAND SURVEY MONUMENT RECORD

SECTION 4 T 18 N, R 6 W, TOWN OF Farmington

LA CROSSE COUNTY

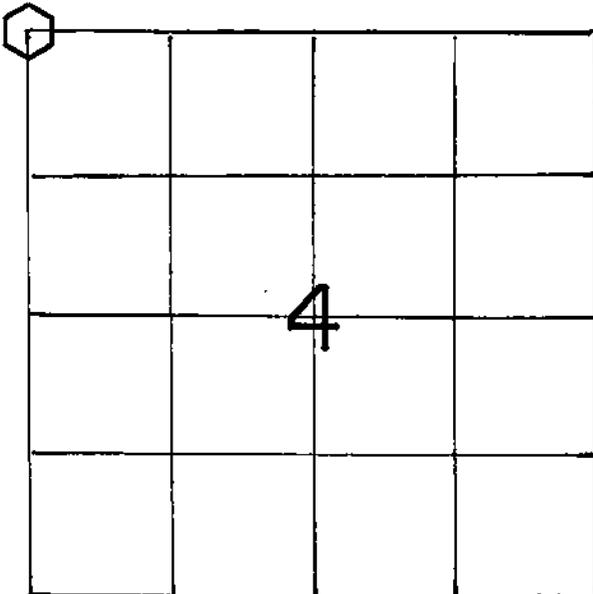

LOCATION OF LANDMARK

Crew: WILLIAM C. JUNG
PETER F. FOLLANSBEE

Date: 3/29/1994

Crew: William C. Jung
Peter F. Follansbee

Dates: 8/4/94 and 12/2/94 and 4/11/96

Describe any record evidence, monument evidence, testimonial evidence or any other material evidence you considered and whether the monument was found or restored through acceptance of an obliterated evidence location.

Blencoe set an iron bar at this corner in 1924. I found this bar and replaced it with a brass capped Lunde marker.

We had to remove and then reset this corner because of road construction.

Describe or show any material discrepancy between the location of the restored corner and that of the corner previously restored or reestablished.

None Known.

WISCONSIN COORDINATE SYSTEM

North

East

Theta Angle

Horiz. Order

Vert. Order

TYPE OF LANDMARK

Set brass cap Lunde marker.

BEARINGS ARE REFERENCED TO


Assumed North.

 $\frac{1}{5/8/07}$

RECORD OF DURABLE WITNESS MONUMENTS


MAGNETIC

NO	DESCRIPTION	BEARING	DISTANCE
1	Exist. P.K. Nail in approximate centerline	East ±	165.52 Ft. 164.26
2	Exist. 3/4" Rebar 6" west of exist. Stone	S 81° E	166.20 Ft.
3	Set P.K. Nail in W. side 24" Oak (unblazed)	S 29° E	67.58 Ft.
4	Set P.K. Nail in E. side 17" Oak (unblazed)	S 07° E	54.75 Ft.

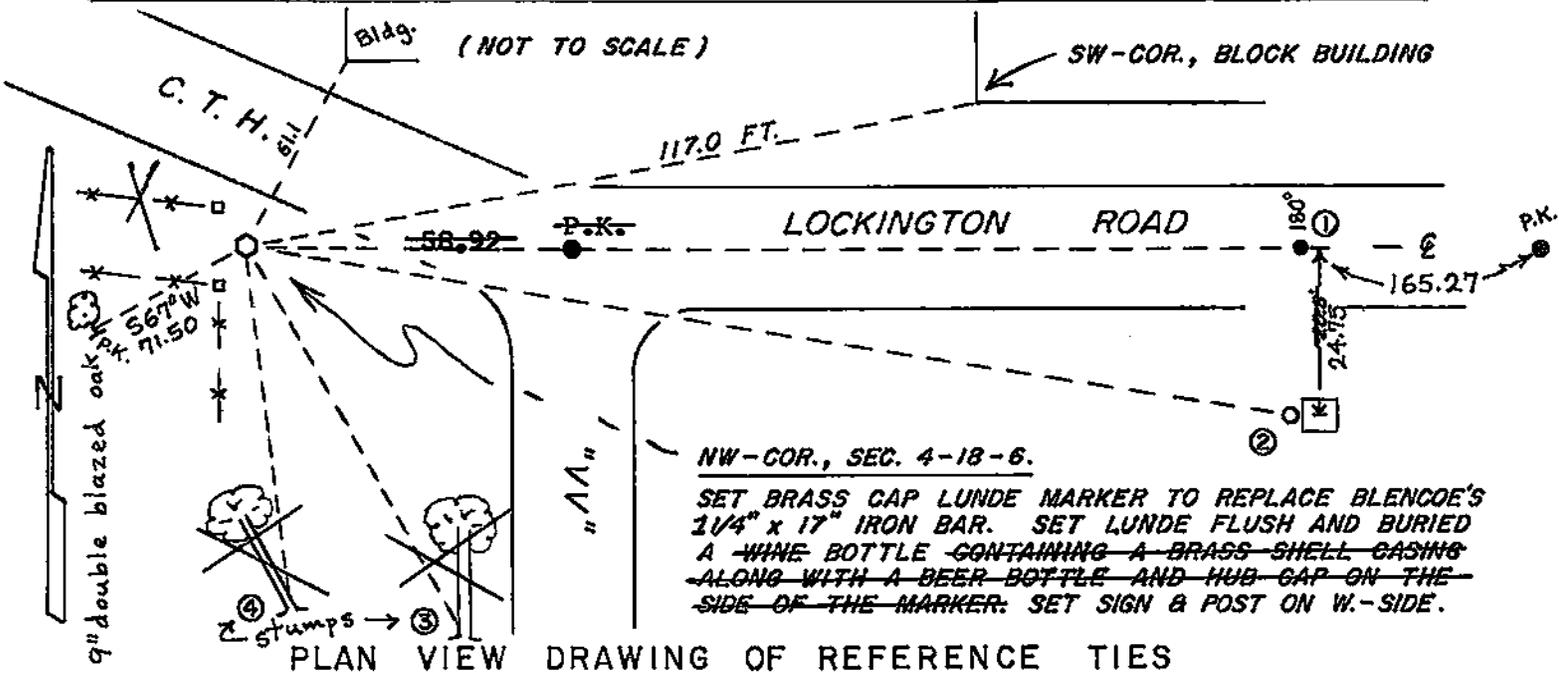

MAP SHOWING DISTANCE AND DIRECTION TO OTHER PUBLIC LAND SURVEY CORNERS USED FOR REESTABLISHING THE CORNER

(not to scale)

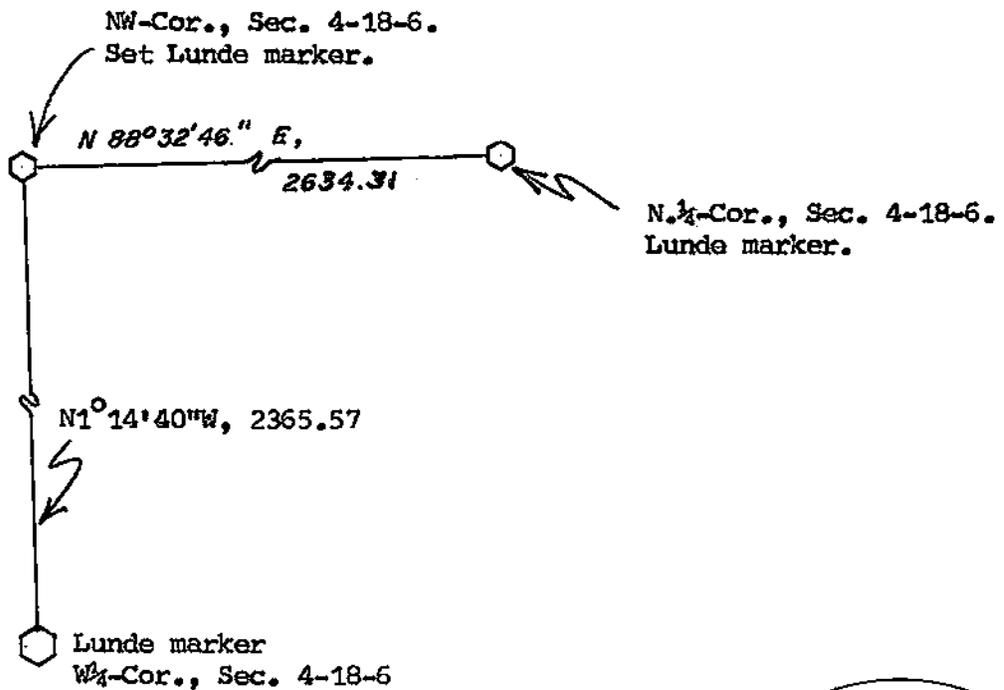

I, William C. Jung, County Surveyor
HEREBY CERTIFY THAT THE CORNER LOCATION SHOWN ON THIS RECORD WAS DETERMINED BY ME OR UNDER MY DIRECTION AND CONTROL AND THAT THIS U. S. PUBLIC LAND SURVEY MONUMENT RECORD IS CORRECT AND COMPLETE TO THE BEST OF MY KNOWLEDGE AND BELIEF.

William C. Jung 6/14/94
Signature Date

Revised: 12/3/96 *w.c.j.*

Revised: 3/8/95 *w.c.j.*

