


21906320020

U. S. PUBLIC LAND SURVEY MONUMENT RECORD

SECTION 5 T 18 N, R 6 W, TOWN OF Farmington
 LA CROSSE COUNTY

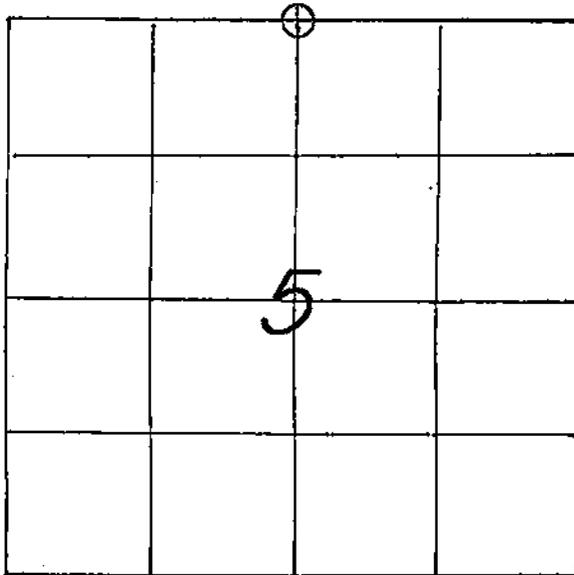

LOCATION OF LANDMARK

Crew: William C. Jung
 Peter F. Follansbee

Date: 2/2/99

Describe any record evidence, monument evidence, testimonial evidence or any other material evidence you considered and whether the monument was found or restored through acceptance of an obliterated evidence location.

Dave Blencoe, the Jackson County Surveyor from many years ago, had determined the location of this corner in a former survey. Based on the field evidence, Norm Hurlburt was able to establish Blencoe's old location. After reviewing the evidence with Norm, I agree with his conclusions. I set an iron bar with a cap at Norm's corner location.


Describe or show any material discrepancy between the location of the restored corner and that of the corner previously restored or reestablished.

None known.

WISCONSIN COORDINATE SYSTEM
North
East
Theta Angle
Horiz. Order
Vert. Order
TYPE OF LANDMARK
3/4"x30 iron bar w/cap
BEARINGS ARE REFERENCED TO

RECORD OF DURABLE WITNESS MONUMENTS

NO	DESCRIPTION	BEARING	DISTANCE
1	SET A P.K. NAIL IN N.W.-SIDE OF A 5" OAK	N 31° E (MAG.)	5.33 FT.
2	SET A P.K. NAIL IN S.W.-SIDE OF A 9-1/2" OAK	S 10° E (MAG.)	26.67 FT.
3	SET A P.K. NAIL IN E.-SIDE OF A 10-1/2" OAK	SOUTHERLY ±	28.08 FT.
4	SET A P.K. NAIL IN E.-SIDE OF A 10-1/2" OAK	SOUTHERLY ±	29.03 FT.

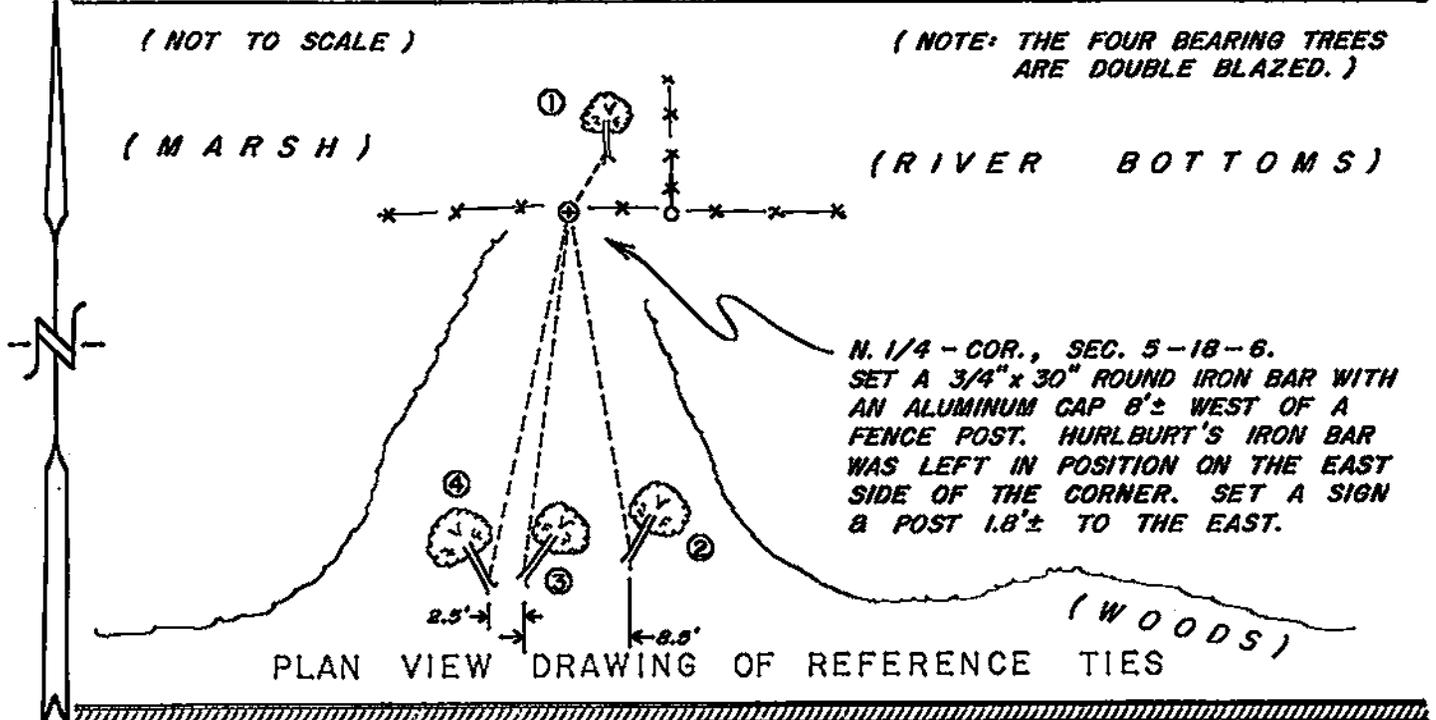


MAP SHOWING DISTANCE AND DIRECTION TO OTHER PUBLIC LAND SURVEY CORNERS USED FOR REESTABLISHING THE CORNER

No section measurements were made by me at this time. The location of this corner was determined by Hurlburt.

I, WILLIAM C. JUNG, COUNTY SURVEYOR
 HEREBY CERTIFY THAT THE CORNER LOCATION SHOWN ON THIS RECORD WAS DETERMINED BY ME OR UNDER MY DIRECTION AND CONTROL AND THAT THIS U. S. PUBLIC LAND SURVEY MONUMENT RECORD IS CORRECT AND COMPLETE TO THE BEST OF MY KNOWLEDGE AND BELIEF.

William C. Jung 2/4/99
 Signature Date

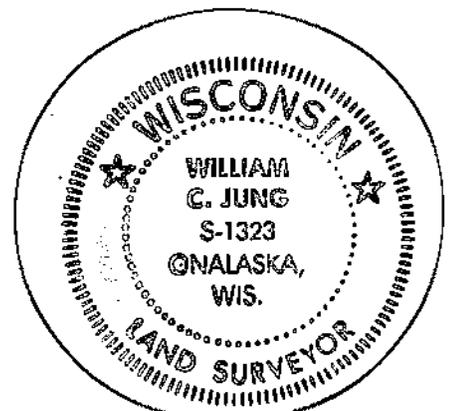

Seal