


U. S. PUBLIC LAND SURVEY MONUMENT RECORD

SECTION 3 T 18 N, R 6 W, TOWN OF Farmington

LA CROSSE COUNTY

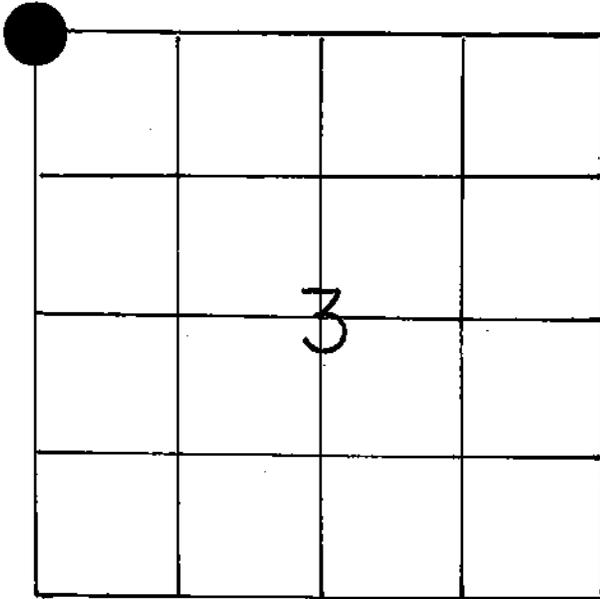

LOCATION OF LANDMARK

Crew: WILLIAM C. JUNG
PETER F. FOLLANSBEE

Crew: William C. Jung
Peter F. Follansbee

Date: 12/09/1988

Date: 3/28/94

Describe any record evidence, monument evidence, testimonial evidence or any other material evidence you considered and whether the monument was found or restored through acceptance of an obliterated evidence location.

In November of 1933 Dave Blencoe found remnants of the original government bearing trees and set a stone at the original government corner position. He also set stones 24.75' to the North and South. In February of 1968 Ray Hurlburt thought that the stone may have been destroyed by road grading. Otho Bergman set an iron bar at this corner in 1977. It is 24.75' North of Blencoe's witness stone. This location North of the witness stone has been used in other surveys as well. I set a railroad spike over the iron bar. *****

Describe or show any material discrepancy between the location of the restored corner and that of the corner previously restored or reestablished.

NONE KNOWN

***** 3/28/94

Replaced railroad spike and iron bar with a brass capped Lunde marker.

WISCONSIN COORDINATE SYSTEM

North

East

Theta Angle

Horiz. Order

Vert. Order

TYPE OF LANDMARK


~~SET RAILROAD SPIKE~~ Lunde marker

BEARINGS ARE REFERENCED TO


Assumed

RECORD OF DURABLE WITNESS MONUMENTS

NO	DESCRIPTION	BEARING	DISTANCE
1	Set P.K. Nail in 5" Oak (Double Blazed)	-----	121.94 Ft. 121.92
2	Set P.K. Nail in W-side of new Power Pole	-----	31.63 Ft. 31.65
3	Ext. P.K. Nail in 14" Oak (Unblazed)	-----	53.25 Ft.
4	Ext. Witness Stone w/sign and post	South±	24.61 Ft.

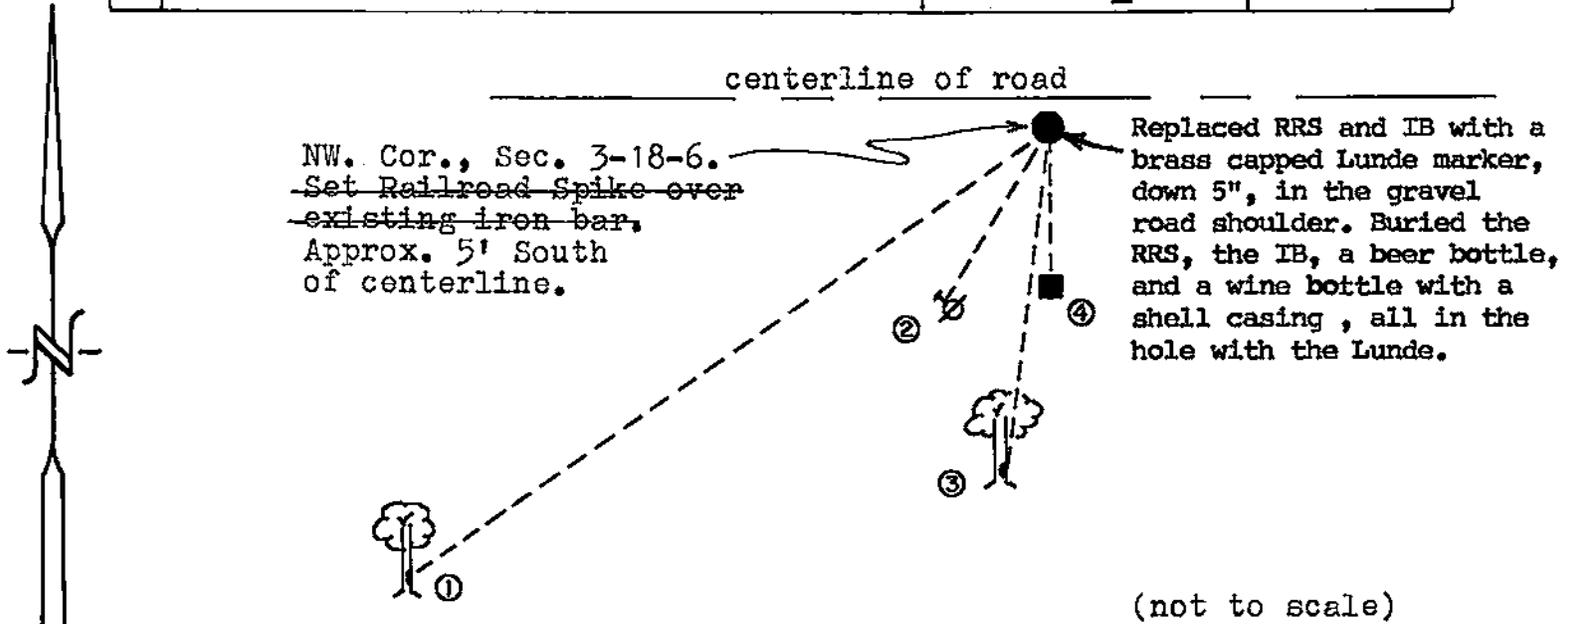


PLAN VIEW DRAWING OF REFERENCE TIES

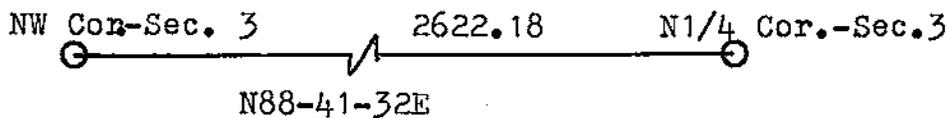

I, William C. Jung, Deputy County Surveyor
 HEREBY CERTIFY THAT THE CORNER LOCATION SHOWN ON THIS RECORD
 WAS DETERMINED BY ME OR UNDER MY DIRECTION AND CONTROL AND
 THAT THIS U. S. PUBLIC LAND SURVEY MONUMENT RECORD IS CORRECT
 AND COMPLETE TO THE BEST OF MY KNOWLEDGE AND BELIEF.

William C. Jung 3/2/89
 Signature Date

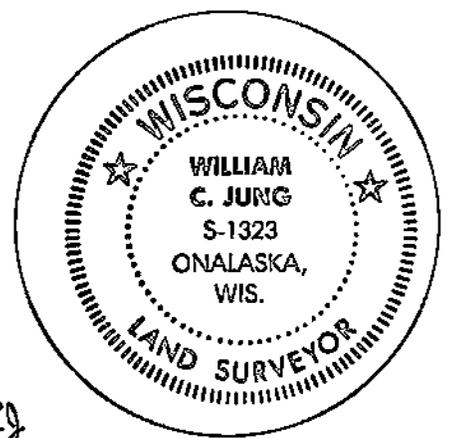

Seal

Revised: 6/15/94 *wcj*