


U. S. PUBLIC LAND SURVEY MONUMENT RECORD

SECTION 4 T 18 N, R 6 W, TOWN OF FARMINGTON

LA CROSSE COUNTY

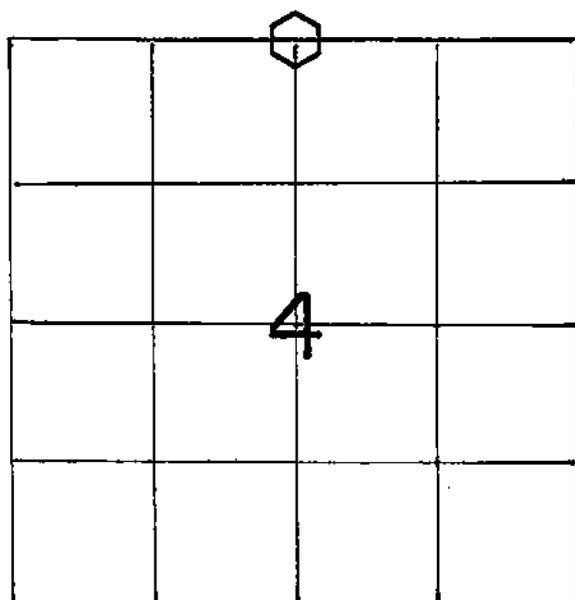

LOCATION OF LANDMARK

Crew: WILLIAM C. JUNG
PETER F. FOLLANSBEE

Date: 3/29/94

Describe any record evidence, monument evidence, testimonial evidence or any other material evidence you considered and whether the monument was found or restored through acceptance of an obliterated evidence location.

I replaced an existing iron pin with a brass capped Lunde marker. I believe that this pin was set by Bergman to remonument Blencoe's 1/4 corner as re-established in 1924.

Describe or show any material discrepancy between the location of the restored corner and that of the corner previously restored or reestablished.

None Known.

WISCONSIN COORDINATE SYSTEM

North

East

Theta Angle

Horiz. Order

Vert. Order

TYPE OF LANDMARK


Set brass cap Lunde marker.

BEARINGS ARE REFERENCED TO

Assumed North


RECORD OF DURABLE WITNESS MONUMENTS

| NO | DESCRIPTION | BEARING | DISTANCE |
|----|--|-----------------|-----------|
| 1 | Set P.K. Nail in NE-side 17" Oak(unblazed) | Northwesterly ± | 27.98 Ft. |
| 2 | Southeast corner of conc. house foundation. | Northwesterly ± | 40.05 Ft. |
| 3 | Set P.K. Nail in NE-side 8" Norway(unblazed) | Southeasterly ± | 46.25 Ft. |
| 4 | Existing 2½" Iron Pipe (O.D.) | South ± | 24.52 Ft. |

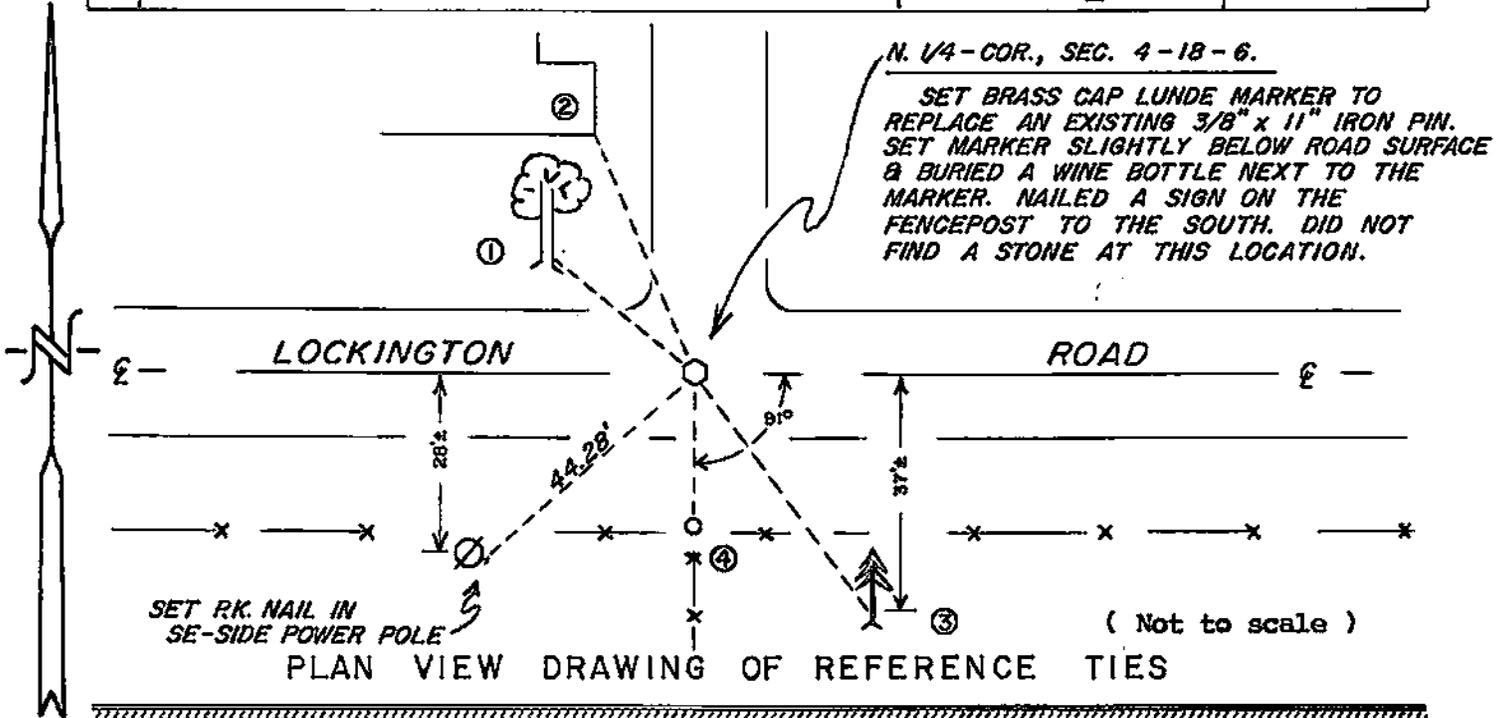

MAP SHOWING DISTANCE AND DIRECTION TO OTHER PUBLIC LAND SURVEY CORNERS USED FOR REESTABLISHING THE CORNER

(not to scale)

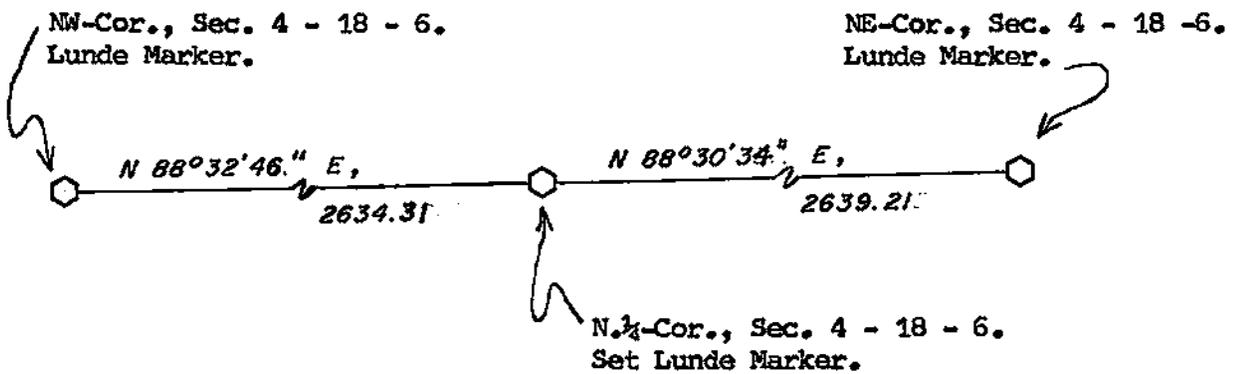

I, William C. Jung, County Surveyor
 HEREBY CERTIFY THAT THE CORNER LOCATION SHOWN ON THIS RECORD
 WAS DETERMINED BY ME OR UNDER MY DIRECTION AND CONTROL AND
 THAT THIS U. S. PUBLIC LAND SURVEY MONUMENT RECORD IS CORRECT
 AND COMPLETE TO THE BEST OF MY KNOWLEDGE AND BELIEF.

William C. Jung 6/14/94
 Signature Date

