


21906340000

U. S. PUBLIC LAND SURVEY MONUMENT RECORD

SECTION 3 T 18 N, R 6 W, TOWN OF Farmington

LA CROSSE COUNTY

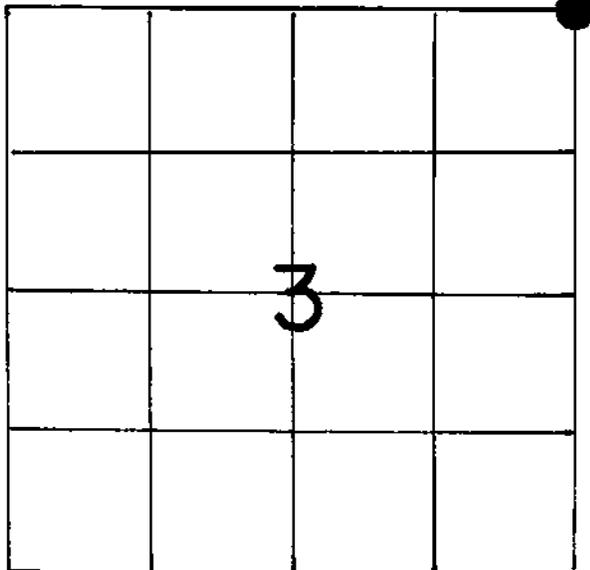

LOCATION OF LANDMARK

Crew: William C. Jung
Peter Follansbee

Date: 2/24/89 8/21/08

WISCONSIN COORDINATE SYSTEM

North

East

Theta Angle

Horiz. Order

Vert. Order

TYPE OF LANDMARK

~~1" iron pipe~~ ** (Lunde)

BEARINGS ARE REFERENCED TO

Assumed

** Replaced the iron pipe with
a brass capped Lunde marker
on 10/23/89. (Jung) *W.C.J.*

Describe any record evidence, monument evidence, testimonial evidence or any other material evidence you considered and whether the monument was found or restored through acceptance of an obliterated evidence location.


Blencoe's notes of December, 1933, would indicate a monument at this corner, but I did not find one. I also did not find any evidence of the original bearing trees, Bliss's bearing trees, or any evidence of Hoffman's corner from 1878. I set the corner by single proportionate measurement between the North 1/4 corners of Sections 1 and 3. I set a pipe at this time because of the deep frost. The corner fit the old East-West fence very well.

Describe or show any material discrepancy between the location of the restored corner and that of the corner previously restored or reestablished.

None known.

RECORD OF DURABLE WITNESS MONUMENTS

NO	DESCRIPTION	BEARING	DISTANCE
1	P.K. in double blazed 9" oak	S17°E	18.68
2	" " " " 10" oak	S80°W	8.42'
3	" " " " 5" white pine	N3°W	16.55'
4	" " " " 7" oak	N39°E	12.81'

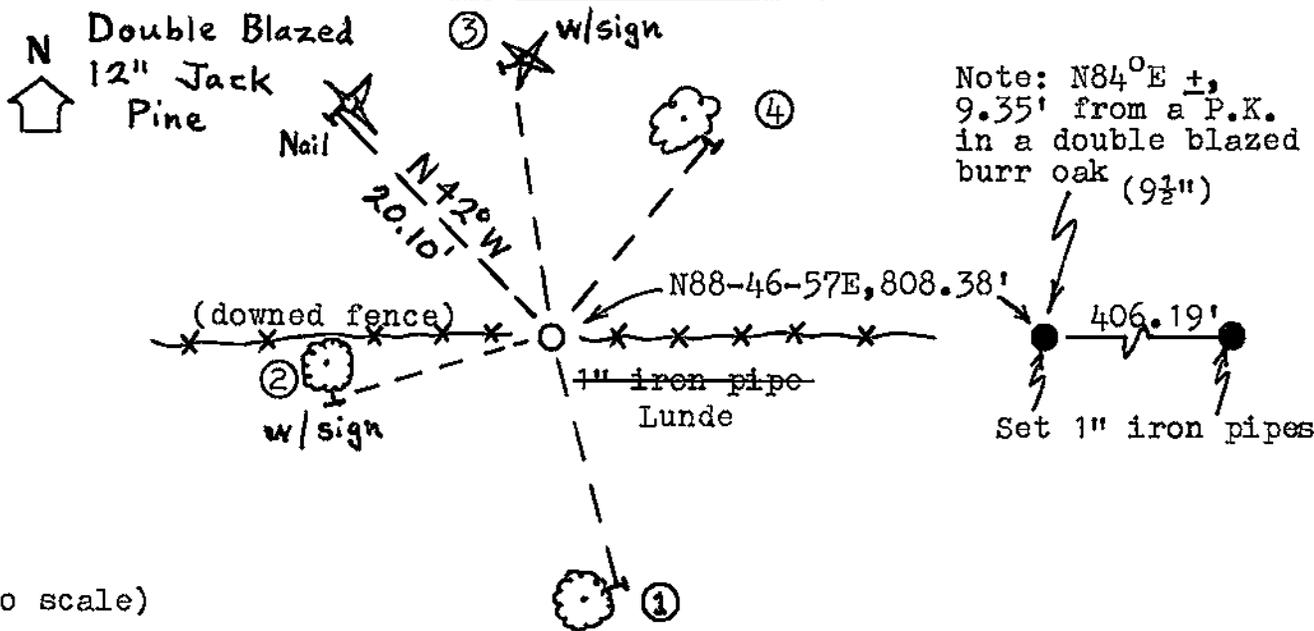


(not to scale)

PLAN VIEW DRAWING OF REFERENCE TIES



MAP SHOWING DISTANCE AND DIRECTION TO OTHER PUBLIC LAND SURVEY CORNERS USED FOR REESTABLISHING THE CORNER

(not to scale)

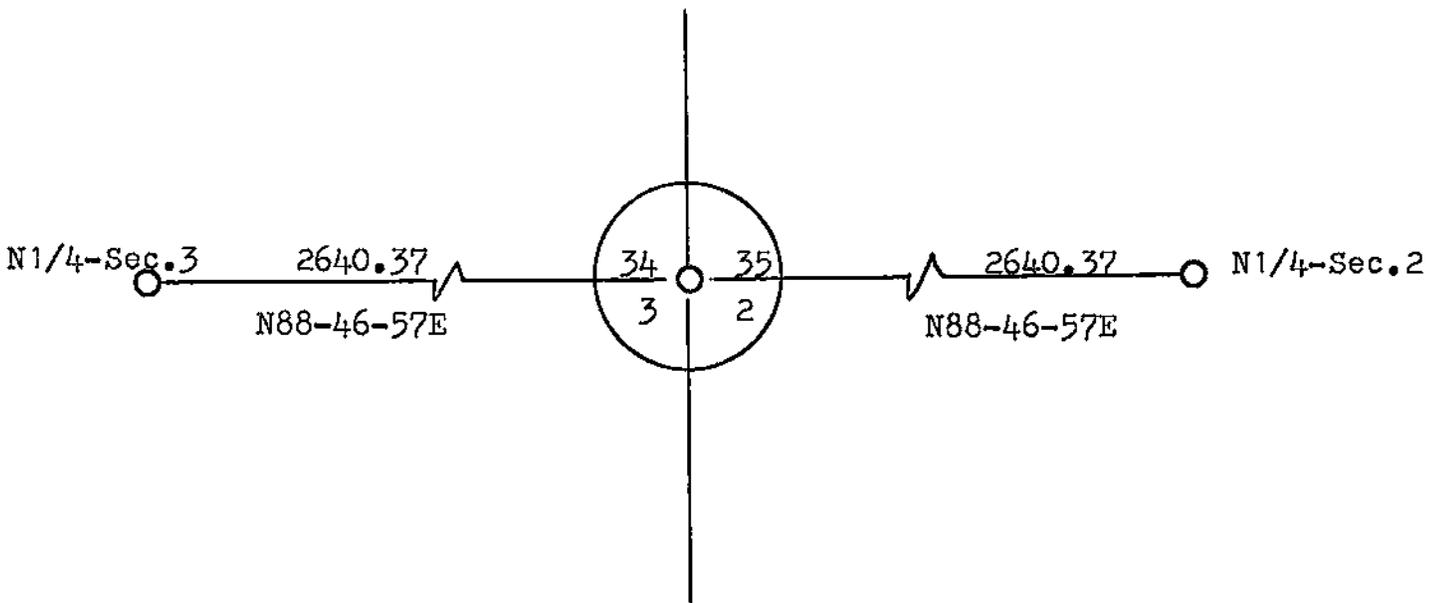


I, William C. Jung, Deputy County Surveyor,
 HEREBY CERTIFY THAT THE CORNER LOCATION SHOWN ON THIS RECORD
 WAS DETERMINED BY ME OR UNDER MY DIRECTION AND CONTROL AND
 THAT THIS U. S. PUBLIC LAND SURVEY MONUMENT RECORD IS CORRECT
 AND COMPLETE TO THE BEST OF MY KNOWLEDGE AND BELIEF.

William C. Jung
 Signature

2/28/89
 Date

Revised: 1/8/90 aweg
11/21/08 aweg

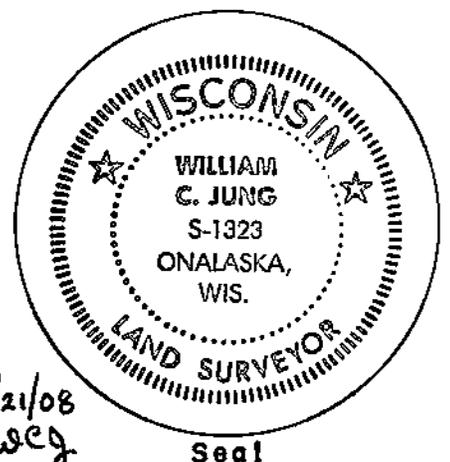

Seal