


U. S. PUBLIC LAND SURVEY MONUMENT RECORD

SECTION 3 T 18 N, R 6 W, TOWN OF Farmington

LA CROSSE COUNTY

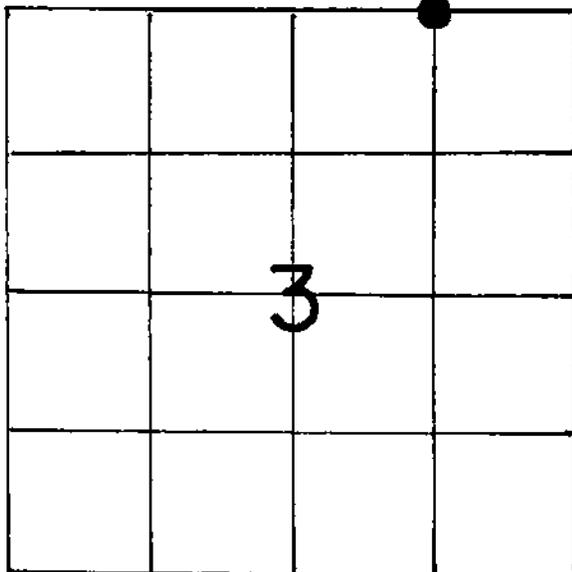

LOCATION OF LANDMARK

Crew: William C. Jung
Peter Follansbee

Date: 2/24/89

Describe any record evidence, monument evidence, testimonial evidence or any other material evidence you considered and whether the monument was found or restored through acceptance of an obliterated evidence location.

I set this "40" corner by single proportionate measurement between the N1/4 and Northeast corners of Section 3. I found old downed East-West fence in the area of the corner.

Describe or show any material discrepancy between the location of the restored corner and that of the corner previously restored or reestablished.

None known.

WISCONSIN COORDINATE SYSTEM

North

East

Theta Angle

Horiz. Order

Vert. Order

TYPE OF LANDMARK

1" iron pipe

BEARINGS ARE REFERENCED TO

Assumed

