


21906340020

U. S. PUBLIC LAND SURVEY MONUMENT RECORD

SECTION 3 T 18 N, R 6 W, TOWN OF Farmington

LA CROSSE COUNTY

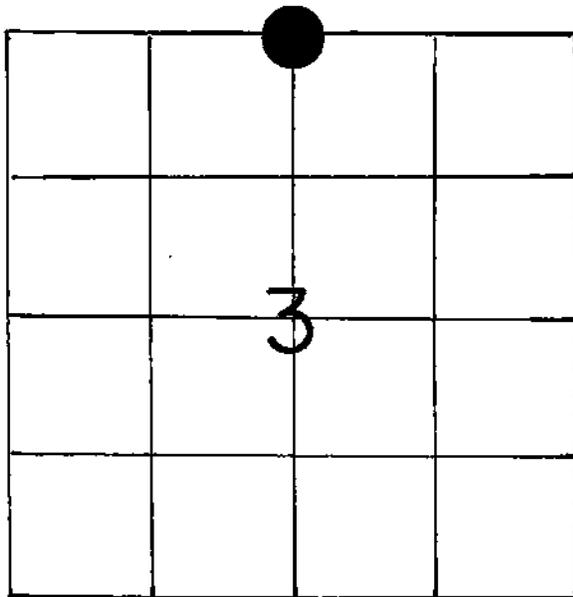

LOCATION OF LANDMARK

WISCONSIN COORDINATE SYSTEM

North

East

Theta Angle

Horiz. Order

Vert. Order

TYPE OF LANDMARK

SET BRASS CAP LUNDE MARKER

BEARINGS ARE REFERENCED TO

Assumed

Crew: WILLIAM C. JUNG
PETER F. FOLLANSBEE

Date: 12/09/1988

Describe any record evidence, monument evidence, testimonial evidence or any other material evidence you considered and whether the monument was found or restored through acceptance of an obliterated evidence location.


Dave Blencoe set a stone at this corner in November of 1933 and also set stones 24.75' to the North, South, and East. I found the stone at the corner, removed it, and replaced it with a brass capped Lunde marker. I reset the stone on the Northwest side of the Lunde. I could not find the stone to the South, but did find the stone to the East. There was a lot of lumber piled to the North. It was cold and there already was heavy frost in the ground.

Describe or show any material discrepancy between the location of the restored corner and that of the corner previously restored or reestablished.

NONE KNOWN


RECORD OF DURABLE WITNESS MONUMENTS

NO	DESCRIPTION	BEARING	DISTANCE
1	Set P.K. Nail in E-side 10" Norway Pine	S72°W	43.77 Ft.
2	Set P.K. Nail in E-side 9" Norway Pine	S42°W	55.29 Ft.
3	Set P.K. Nail in W-side 10" Norway Pine	S52°E	63.73 Ft.
4	Set P.K. Nail in W-side 9" Norway Pine	S71°E	64.74 Ft.

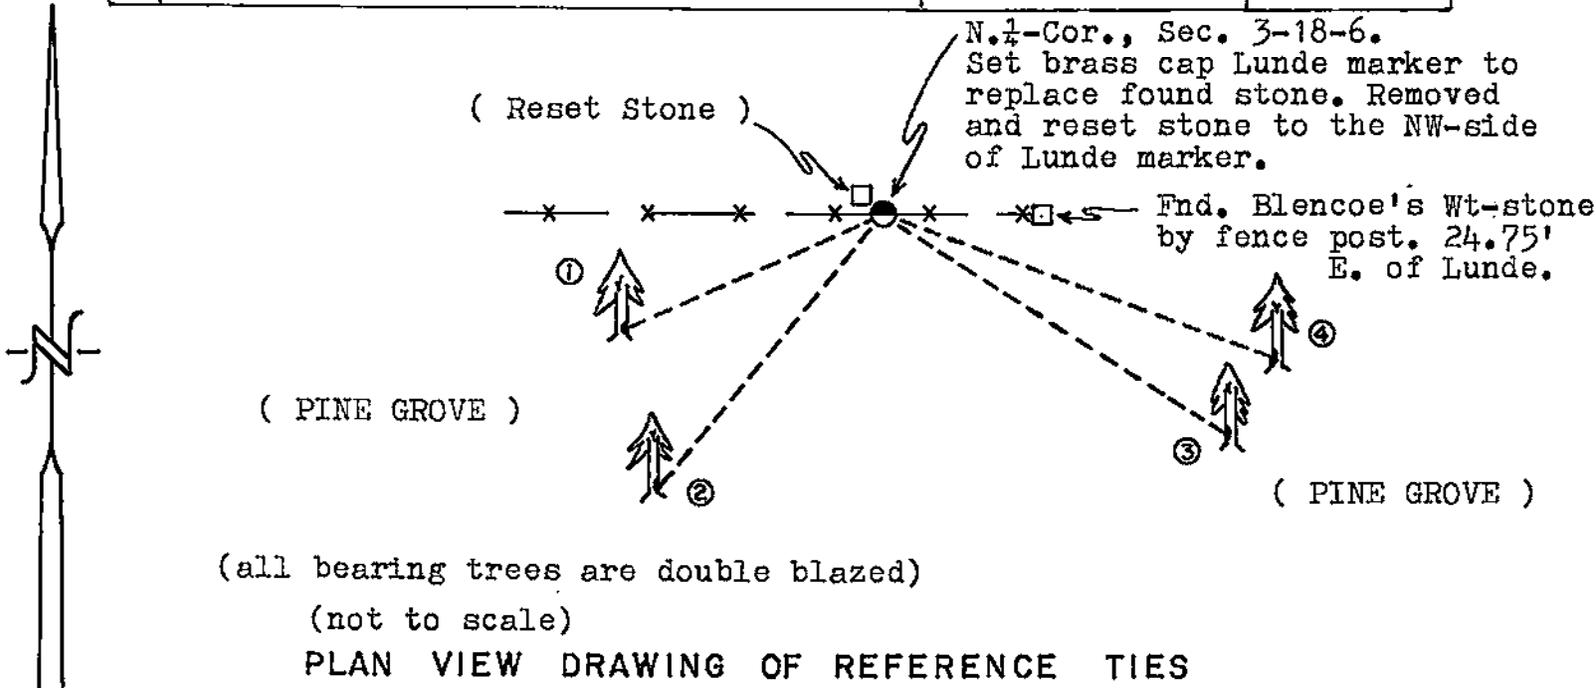


MAP SHOWING DISTANCE AND DIRECTION TO OTHER PUBLIC LAND SURVEY CORNERS USED FOR REESTABLISHING THE CORNER

(not to scale)

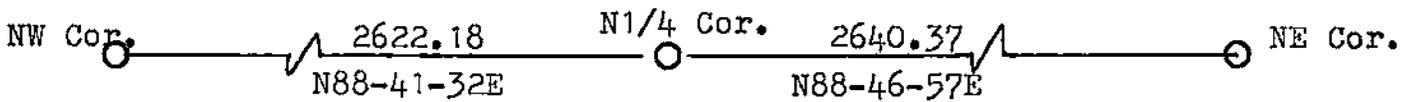

I, William C. Jung, Deputy County Surveyor
HEREBY CERTIFY THAT THE CORNER LOCATION SHOWN ON THIS RECORD
WAS DETERMINED BY ME OR UNDER MY DIRECTION AND CONTROL AND
THAT THIS U. S. PUBLIC LAND SURVEY MONUMENT RECORD IS CORRECT
AND COMPLETE TO THE BEST OF MY KNOWLEDGE AND BELIEF.

William C. Jung 3/2/89
Signature Date

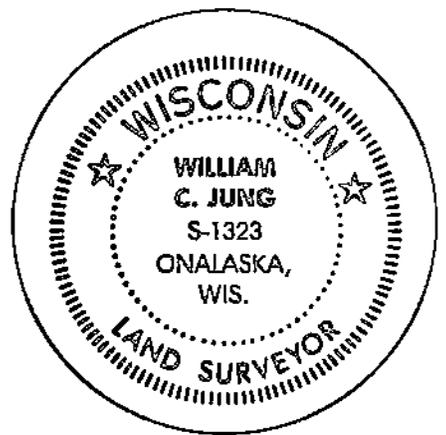

Seal