


U. S. PUBLIC LAND SURVEY MONUMENT RECORD

SECTION 3 T 18 N, R 6 W, TOWN OF Farmington

LA CROSSE COUNTY

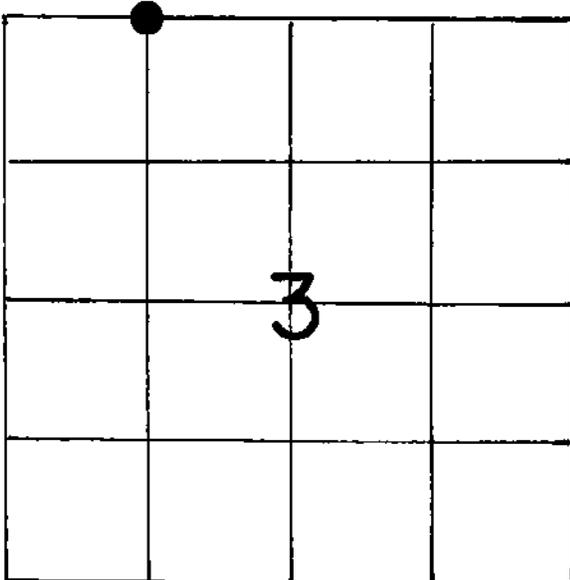

LOCATION OF LANDMARK

Crew: William C. Jung
Peter Follansbee

Date: 2/17/89

Describe any record evidence, monument evidence, testimonial evidence or any other material evidence you considered and whether the monument was found or restored through acceptance of an obliterated evidence location.

In November of 1933 Dave Blencoe set a stone at this corner with stones 24.75 feet North and South. I found the stone at the corner disturbed somewhat, the stone to the North disturbed, and the stone to the South undisturbed. I set an iron pipe (with Blencoe's stone to the West) at the corner and straightened the reference stone to the North.

Describe or show any material discrepancy between the location of the restored corner and that of the corner previously restored or reestablished.

The pipe is 0.82' North and 0.79' East of the true corner.

WISCONSIN COORDINATE SYSTEM

North

East

Theta Angle

Horiz. Order

Vert. Order

TYPE OF LANDMARK

Set 1" iron pipe by stone

BEARINGS ARE REFERENCED TO

Assumed

