


U. S. PUBLIC LAND SURVEY MONUMENT RECORD

SECTION 2 T 18 N, R 6 W, TOWN OF Farmington
 LA CROSSE COUNTY

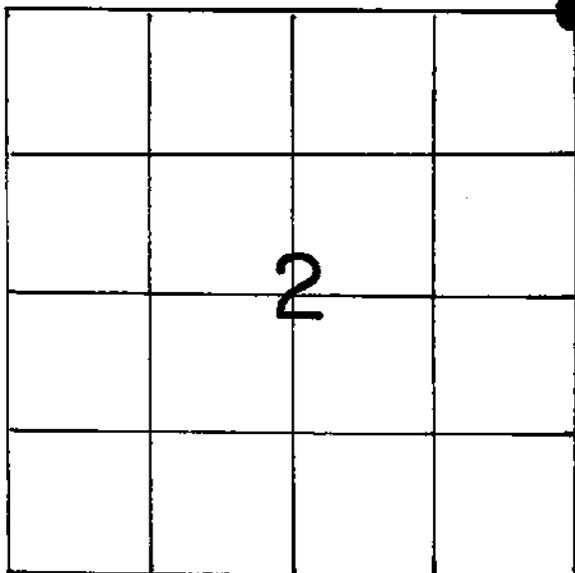

LOCATION OF LANDMARK

Crew: William C. Jung
 Peter Follansbee

Date: 3/1/89

Describe any record evidence, monument evidence, testimonial evidence or any other material evidence you considered and whether the monument was found or restored through acceptance of an obliterated evidence location.

I set the corner by single proportionate measurement between the North 1/4 corners of Sections 1 and 3. I set a pipe at this time because of the deep frost.

Describe or show any material discrepancy between the location of the restored corner and that of the corner previously restored or reestablished.

None known.

WISCONSIN COORDINATE SYSTEM

North
East
Theta Angle
Horiz. Order
Vert. Order

TYPE OF LANDMARK

~~1" iron pipe~~ ** (Lunde)

BEARINGS ARE REFERENCED TO


Assumed

** Replaced the iron pipe with a Lunde marker on 10/23/89. John Ellingson, Jackson County Surveyor, set a survey sign on a post about 2' West of the corner.

west

RECORD OF DURABLE WITNESS MONUMENTS
Magnetic


NO	DESCRIPTION	BEARING	DISTANCE
1	P.K. nail in double blazed 17" white pine	S27°W	27.04
2	" " " " " 10" burr oak	N40°W	11.93
3	" " " " " 12" burr oak	N 4°E	33.20
4	" " " " " 5" cedar	N41°E	44.61

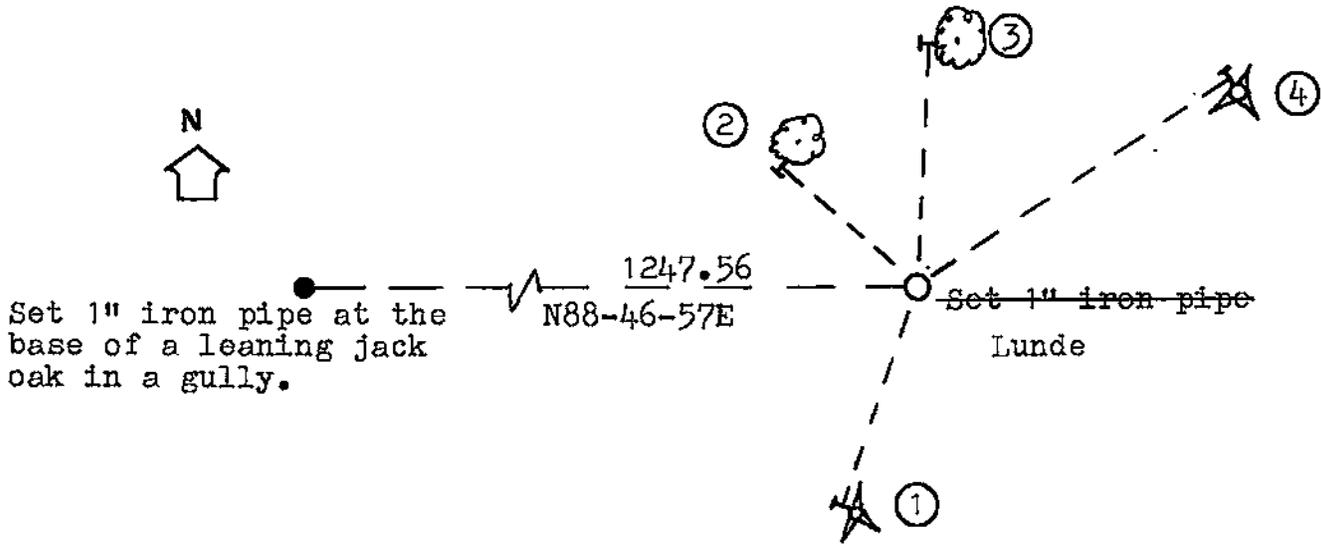

PLAN VIEW DRAWING OF REFERENCE TIES



MAP SHOWING DISTANCE AND DIRECTION TO OTHER PUBLIC LAND SURVEY CORNERS USED FOR REESTABLISHING THE CORNER

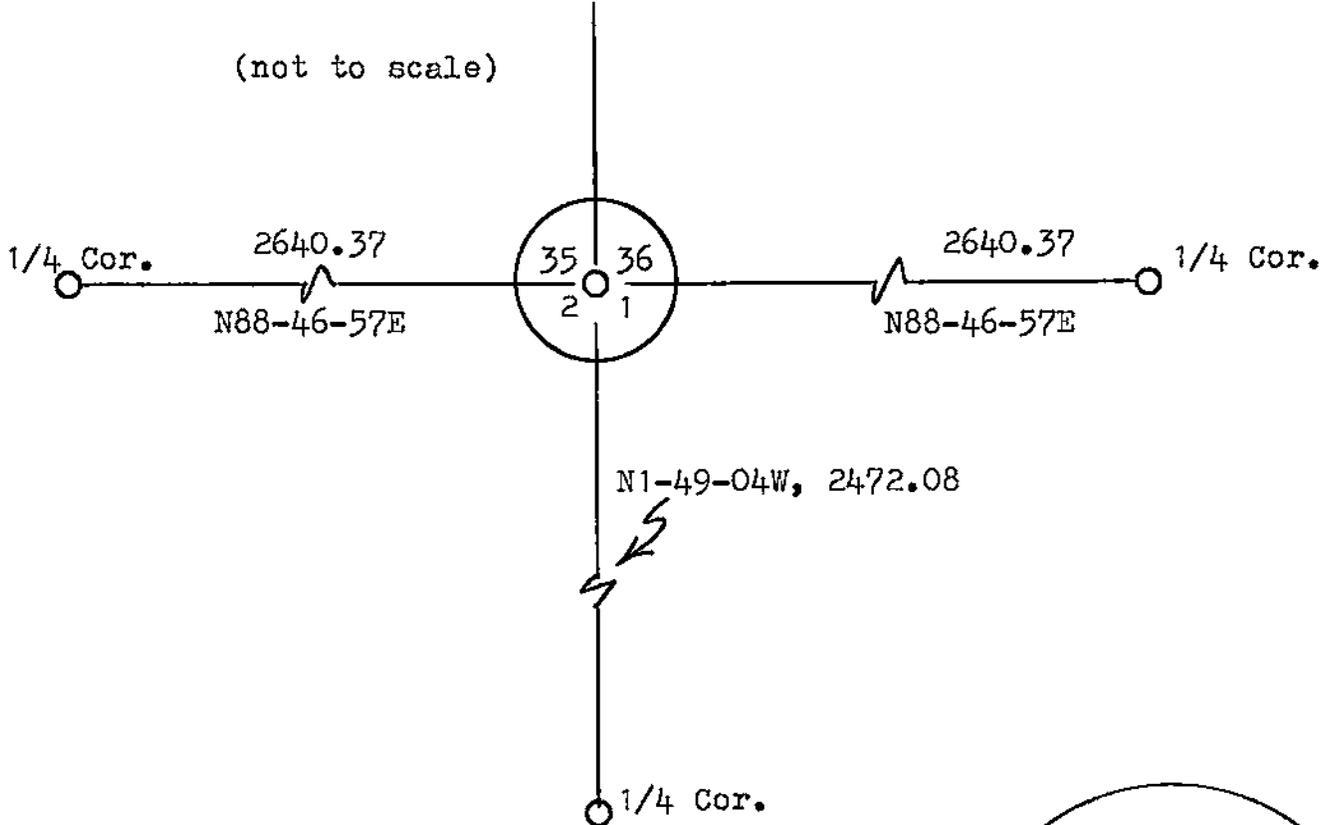


I, William C. Jung, Deputy County Surveyor,
HEREBY CERTIFY THAT THE CORNER LOCATION SHOWN ON THIS RECORD
WAS DETERMINED BY ME OR UNDER MY DIRECTION AND CONTROL AND
THAT THIS U. S. PUBLIC LAND SURVEY MONUMENT RECORD IS CORRECT
AND COMPLETE TO THE BEST OF MY KNOWLEDGE AND BELIEF.

William C. Jung
Signature

3/2/89
Date

Revised: 1/8/90 *wef*

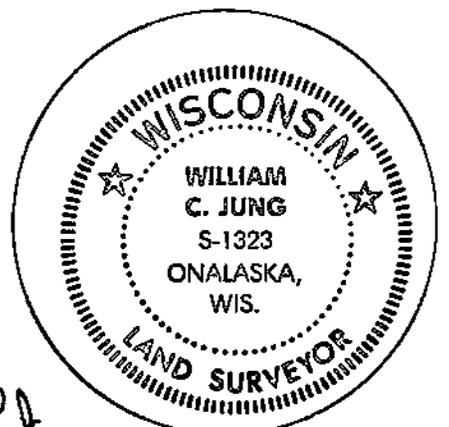

Seal