


U. S. PUBLIC LAND SURVEY MONUMENT RECORD

SECTION 2 T 18 N, R 6 W, TOWN OF Farmington

LA CROSSE COUNTY

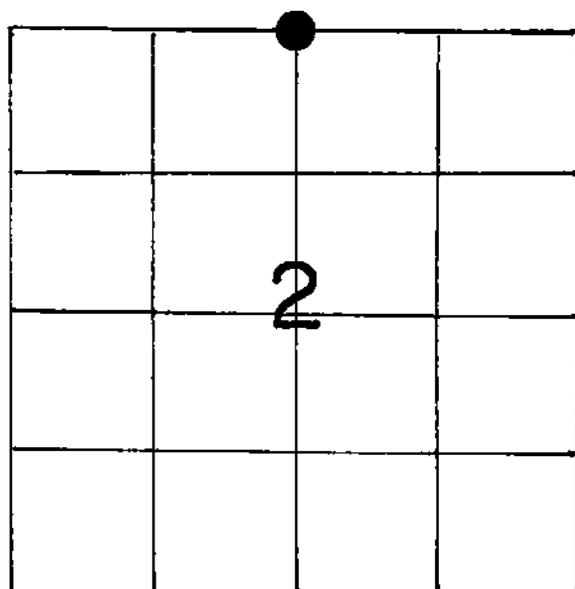

LOCATION OF LANDMARK

Crew: William C. Jung
Peter Follansbee

Date: 3/1/89

Describe any record evidence, monument evidence, testimonial evidence or any other material evidence you considered and whether the monument was found or restored through acceptance of an obliterated evidence location.

I set the corner by single proportionate measurement between the North 1/4 corners of Sections 1 and 3. I set a pipe at this time because of the deep frost.

Describe or show any material discrepancy between the location of the restored corner and that of the corner previously restored or reestablished.

None known.

Note: About 100' to the South runs a well brushed out random line that we cut and used for traversing East and West through the river bottom forest. On a humorous note to those who follow us, this area is the home (maybe) of the river bottom black bear, the legendary Stevenstown cougar, and certainly the "big buck".

WISCONSIN COORDINATE SYSTEM

North

East

Theta Angle

Horiz. Order

Vert. Order

TYPE OF LANDMARK

~~1" iron pipe~~ ****(Lunde)**

BEARINGS ARE REFERENCED TO


Assumed

**Replaced the iron pipe with a brass capped Lunde marker on 10/23/89. (Jung)

wcj

RECORD OF DURABLE WITNESS MONUMENTS
Magnetic


NO	DESCRIPTION	BEARING	DISTANCE
1	P.K. nail in double blazed 8" oak	S2°E	39.89
2	" " " " " 10" jack pine	N73°W	8.46
3	" " " " " 9" double oak	N9°E	28.04
4	" " " " " 4" oak	S62°E	27.71

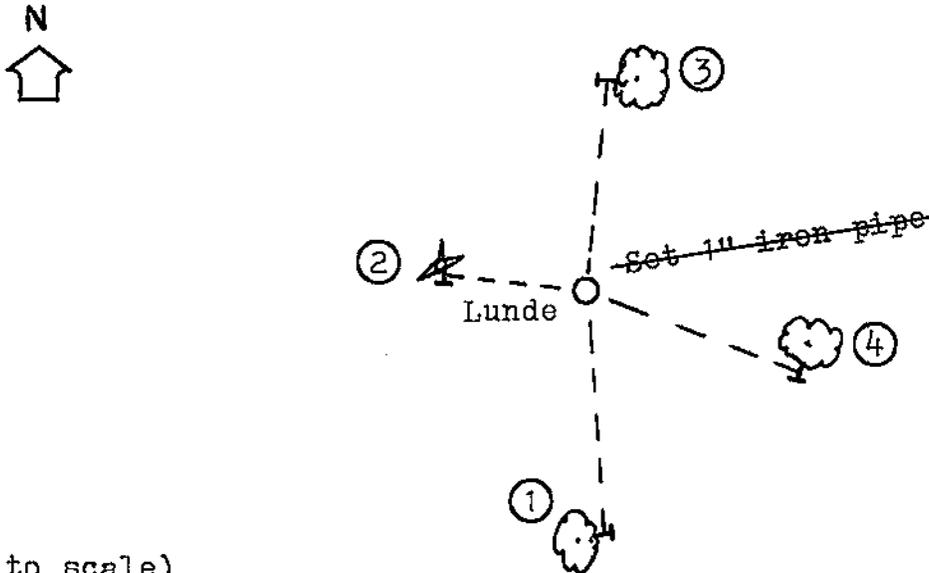

(not to scale)

PLAN VIEW DRAWING OF REFERENCE TIES

MAP SHOWING DISTANCE AND DIRECTION TO OTHER PUBLIC LAND SURVEY CORNERS USED FOR REESTABLISHING THE CORNER

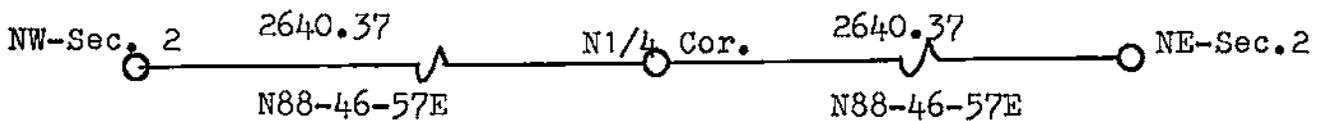


(not to scale)

I, William C. Jung, Deputy County Surveyor,
HEREBY CERTIFY THAT THE CORNER LOCATION SHOWN ON THIS RECORD
WAS DETERMINED BY ME OR UNDER MY DIRECTION AND CONTROL AND
THAT THIS U. S. PUBLIC LAND SURVEY MONUMENT RECORD IS CORRECT
AND COMPLETE TO THE BEST OF MY KNOWLEDGE AND BELIEF.

William C. Jung
Signature

3/2/89
Date
Revised: 1/8/90 *wej*

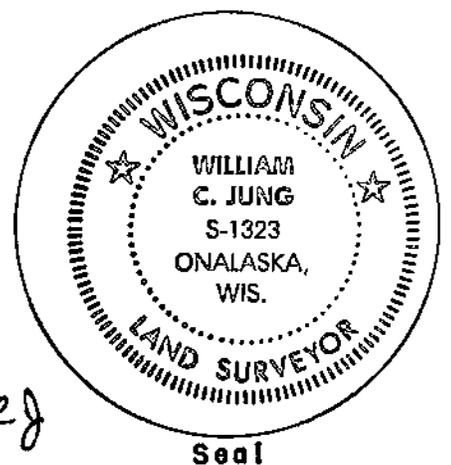

Seal