

RECORD OF LAND CORNER PERPETUATION

No. _____

STATE OF WISCONSIN

County of La Crosse } ss.

I, Norman R. Hurlburt, hereby certify that the information shown hereon correctly describes the original corner, resurvey information, evidence found, type of monument found or placed, and witness monuments and accessories used to perpetuate the location of the original or established corner.

Dated this 17 day of July, 1985.

at Black River Falls, Wisconsin.


Norman R. Hurlburt
Registered Land Surveyor
Title

COUNTY La Crosse		
TOWN Farmington		
HIGHWAY none		
SECTION 1	TOWNSHIP 18	RANGE 6W
TYPE OF LANDMARK Section Corner		


Date of Survey April 26, 1985

Drafted by D.W. Melichar

Date July 12, 1985

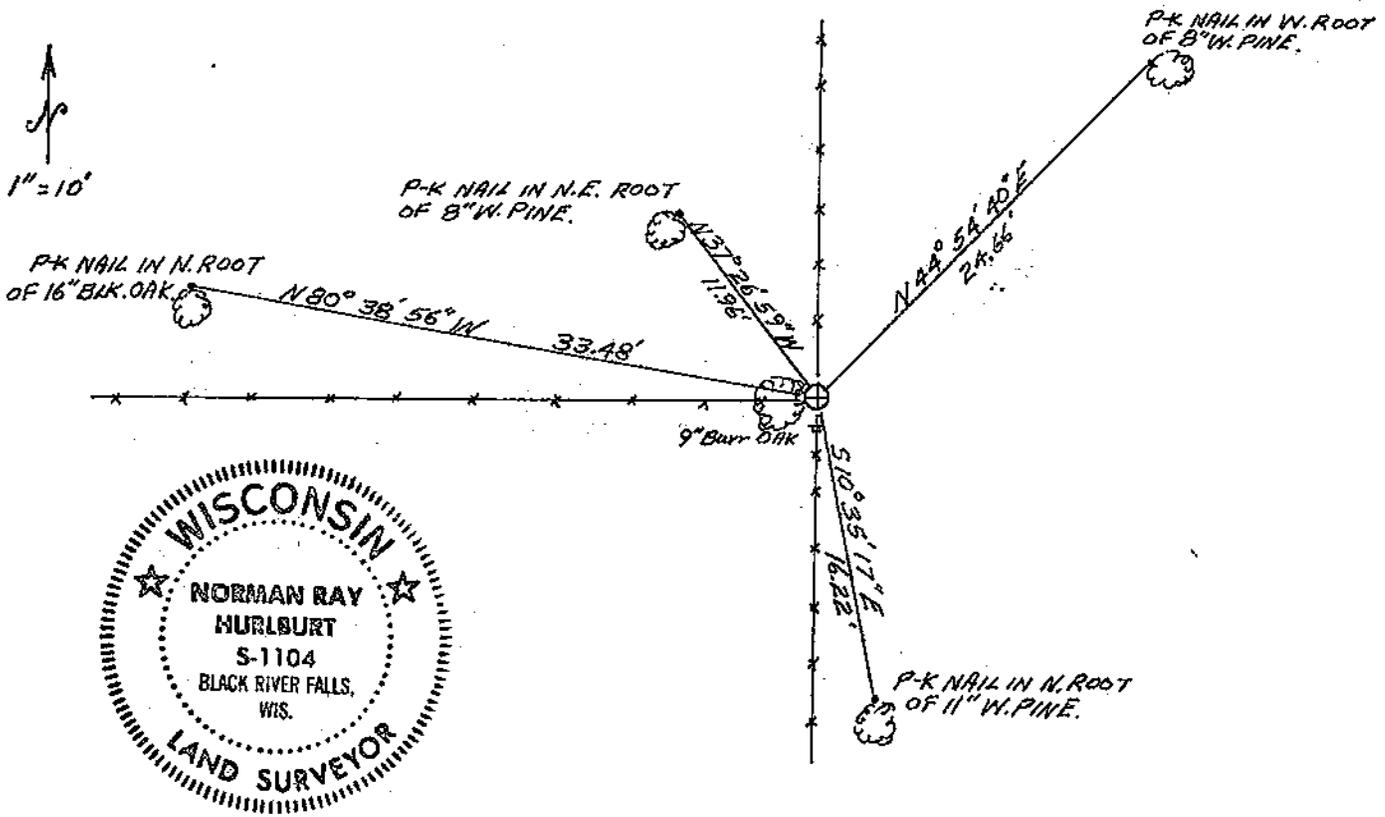

WISCONSIN COORDINATE SYSTEM	
North	Zone
East	
Elevation	Theta Angle
Vertical control order	
Horizontal control order	

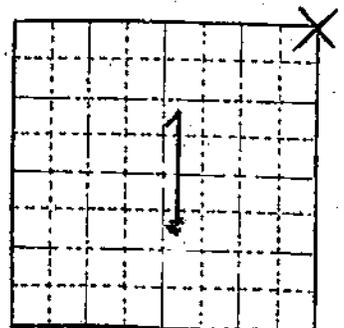

REMARKS: In Jackson County Survey Record No. 2139, Vol. 6, P. 187, dated 1965, Ray W. Hurlburt set a brass capped pipe here beside a Burr Oak Tree used as a fence corner. Prior to this time, there is no record of remonumentation of the corner, but this had been accepted by local residents. We left the pipe as we found it, up 12", and drove a steel witness post 1.0 foot south.

LOCATION SKETCH
(Location of landmark indicated by "x")